


Section 30 Township 30 Range 14W

Well No. 2 Hastings

Company A. Landon etal

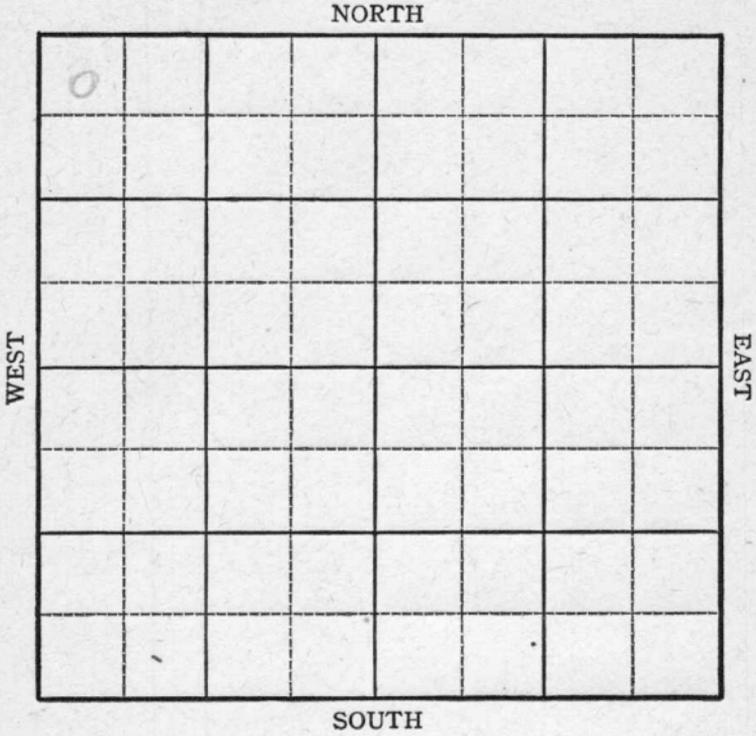

Sec. 30 Twp. 30 R. 14-W

Well No. #2 Hastings Farm

A. Landon et al Company


330 Ft. from N. Line

_____ Ft. from S. Line

_____ Ft. from E. Line

260 Ft. from W. Line

NW/c Elev. 1890

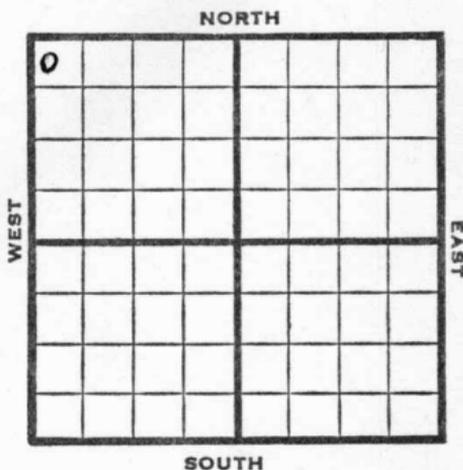

1945

REPORT

9/5	Location
9/12	"
9/19	Anhy 640 8" @ 668 Drlg. 1945
9/26	2680 fsg.
10/3	Drlg. 2860'
10/10	Topeka 3152 Drlg. 3895'
10/17	Lans 4000 Cong 4518 Viola 4532 Drlg. 4607
10/24	Arb. 4723 TD 4775'

ABANDONED

KANSAS

Kansas Pool Name Wildcat

Map No. 92 Sec. 30 Twp. 30 R. 14W

Well No. 2 Hastings

A. Landon etal Company

FIRST REPORT Contractor

NW/c

SECTION PLAT

330 Ft. from N. Line

_____ Ft. from S. Line

_____ Ft. from E. Line

260 Ft. from W. Line

Barber County

0			

Location X

Rig up _____

Drilling and Remarks:

RECORD

Cased _____ in., _____ ft.

Sand _____

Gas _____

Oil _____

Total Depth _____

PRODUCTION

1st 24 hrs. Nat. _____

1st 24 hrs. after shot _____

Gas _____ Cu. Ft.

Dry Hole _____

Abandoned _____

Date

SEP 5 1945 19

S. J. LEWIS Scout

KANSAS Kansas Pool Name Wildcat

Map No. 92 Sec. 30 Twp. 30 R. 14W

Well No. 2 Hastings

A. Landon etal Company

ABANDONED Contractor

NW/c

E1, 1890
SECTION PLAT

330 Ft. from N. Line

_____ Ft. from S. Line

_____ Ft. from E. Line

260 Ft. from W. Line

0			

Barber

Location _____

Rig up _____

Drilling and Remarks:

Per 4723

RECORD

Cased _____ in., _____ ft.

Sand _____

Gas _____

Oil _____

Total Depth 4775

PRODUCTION

1st 24 hrs. Nat. _____

1st 24 hrs. after shot _____

Gas _____ Cu. Ft.

Dry Hole _____

Abandoned _____

Date

OCT 24 1945 19

S. J. LEWIS Scout