

SEC.	TWP.	R.
30	30	14W ✓

WELL NO.

#2

McLain

FARM

COMPANY

Coppinger

CONTRACTOR


Coppinger
Wildcat

330 Ft. from N. Line

Ft. from S. Line

660 Ft. from E. Line

Ft. from W. Line

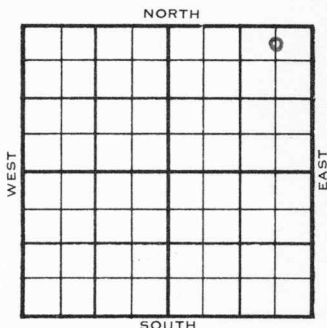

C N L NE NE

	ELEVATION	REPORT
1953	1797'	
11/11	MIR	
11/18	Lost two joints surf. pipe.	
12/9	Skid 50' SW 8" @ 780'	
12/16	Drlg 2585'	
1954 1/6	Spud 11-10-53 D&A TD 4625' 8" @ 753' Lost 2 jts. surface pipe Skid 50' sw, 8" @ 780' Top 3078', Heeb 3729', Tor 3749', Doug 3798', Br lime 3904', Lans 3919', Viola 4440' DST 4456-70', opn 1 hr., rec. 20' sgcm, 25# Simp 4496' DST 4498-4507', opn 1/2 hrs., rec. 15' sgcm, 1000# DST 4498-4527', opn 1 hr., rec. 3285' sw, 1512# Arb. 4602'	

(Information Brought Forward)

1954

1/6

TD 4625'

D&A

ABANDONED

NOV 12 1953

Scout Cards	12
Land Small Map	
Land Wall Map	32
Tracings	
France Map	
Pierce Map	
Misc.	

Kansas

Map No. _____ Sec. 30 Twp. 30 R. 14W

Well No. 2 McLain

Coppinger Company

CORRECTION

Contractor

C N L NE NE


SECTION PLAT

330 Ft. from N. Line

_____ Ft. from S. Line

660 Ft. from E. Line

_____ Ft. from W. Line

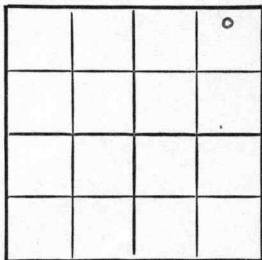

Barber County

Location _____

Rig up _____

Drilling and Remarks:

Reported
#1 McLain

RECORD

Cased _____ in., _____ ft.

Sand _____

Gas _____

Oil _____

Total Depth _____

PRODUCTION

1st 24 hrs. Nat. _____

1st 24 hrs. after shot _____

Gas _____ Cu. Ft.

Dry Hole _____

Abandoned _____

Date

DEC 30 1952

19

J. G. McGEHEE

Scout


Map No. _____ Sec. _____ Twp. _____ R. _____

Well No. _____

Company _____

Contractor _____

SECTION PLAT

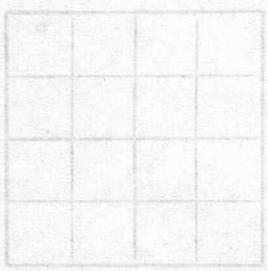

_____ Ft. from N. Line

_____ Ft. from E. Line

_____ Ft. from S. Line

_____ Ft. from W. Line

RECORD	Location
Cased _____ in _____ ft.	_____
Sand _____	_____
Gas _____	_____
Oil _____	_____
Total Depth _____	_____

- Scout Cards *mm*
- Land Small Map _____
- Land Wall Map _____
- Tracings _____
- France Map _____
- Pierce Map _____
- Misc. _____

JAN 4 1954

Date _____

JAN 12 1954

02

Scout Cards
Land Small Map
Land Wall Map
Tracings
France Map
Pierce Map
Misc.

