
FORM 51 5M 11-44 PETROL KANSAS Grant County

Section 30 Township 30 Range 35W

Well No. #1 Gilbert

Company United Prod.

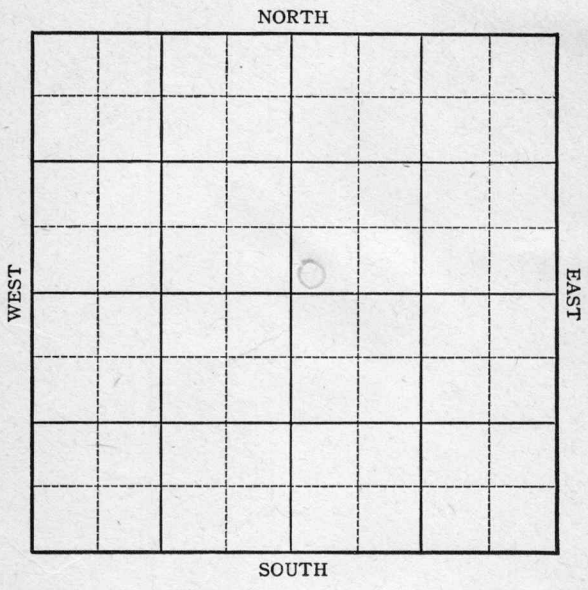

FORM 252-A
5M 3-45 PETROL

KANSAS


Grant County

Sec. 30 Twp. 30S R. 35W

Well No. #1 Gilbert Farm

United Prod. Company

Hugoton

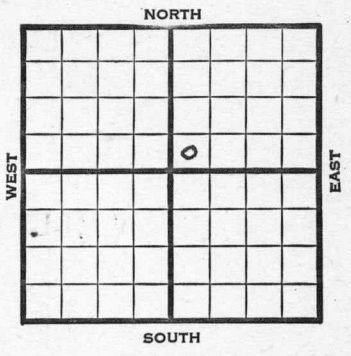

____ Ft. from N. Line

100 Ft. from S. Line

____ Ft. from E. Line

100 Ft. from W. Line

SW NE Elev. 2932

1945	REPORT
4-4	Rigging up rotary.
4/12	" " "
4/20	10" @ 493' WOC
4/27	7" @ 2465 TD 2467' RUST
5/3	TD 2675 250' of 5" Perf. liner @ 2675
5/10	" " " " " " "
5/17	" " " " " " "
5/24	" " " " " " "
5/31	" " " " " " "
6/8	" " " " " " "
6/14	" " " " " " "
6/21	" " " " " " "
6/28	" " " " " " "
7/3	" " " " " " "
7/11	" " " " " " "
7/19	" " " " " " "
7/26	" " " " " " "
8/1	" " " " " " "
8/8	" " " " " " "
8/15	" " " " " " "
8/22	" " " " " " "
8/29	" " " " " " "
9/5	" " " " " " "
9/12	" " " " " " "
9/19	8000 acid

OVER

1945

9/26 7" @ 2465
250' of 5" Perf. liner @ 2675
8000 acid.
TD 2675'
11,285,000 Gas.
403# R Pr.

COMPLETED

FORM 56 200 BKS, 1-44 PETROL

Pool Name Hugoton

Map No. No Map Sec. 30 Twp. 30 R. 35W


Well No. 1 Gilbert

United Prod. Company

FIRST REPORT Contractor

SW NE

SECTION PLAT

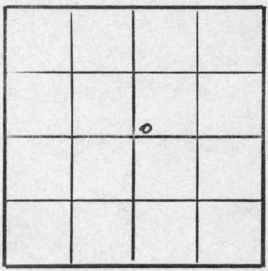

____ Ft. from N. Line

100 Ft. from S. Line

____ Ft. from E. Line

100 Ft. from W. Line

Grant

Location

Rig up

Drilling and Remarks:

RUR

RECORD

Cased ____ in., ____ ft.

Sand

Gas

Oil

Total Depth

PRODUCTION

1st 24 hrs. Nat.

1st 24 hrs. after shot


Gas ____ Cu. Ft.

Dry Hole

Abandoned

Date

APR 4 1945 19 S. J. LEWIS Scout

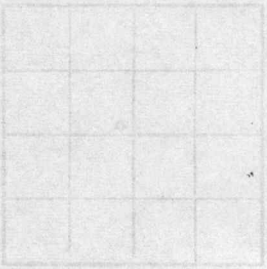

Misc. Small Maps
Cards
Tracing
France Map
Scarborough Map
Pierce Map
Geological Dept.
Pierce Plat Book

FORM 26 200 BKS 1-44 PETROL

KANSAS Kansas Pool Name Hugoton

Map No. on map Sec. 30 Twp. 30 R. 35W

Well No. 1 Gilbert


United Prod. Company

COMPLETED Contractor

SW NE

E 1,2932

SECTION PLAT

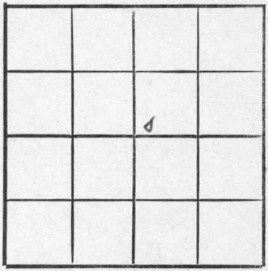

____ Ft. from N. Line

100 Ft. from S. Line

____ Ft. from E. Line

100 Ft. from W. Line

Grant County

Location

Rig up

Drilling and Remarks:

7" @ 2465

250' x 5" Perf liner @ 2625.

8000 acid

11,285,000 Gas.

403# R Pr

RECORD

Cased ____ in., ____ ft.

Sand

Gas

Oil

Total Depth 2625

PRODUCTION

1st 24 hrs. Nat.

1st 24 hrs. after shot

Gas ____ Cu. Ft.


Dry Hole

Abandoned

Date

SEP 26 1945 19

S. J. LEWIS Scout

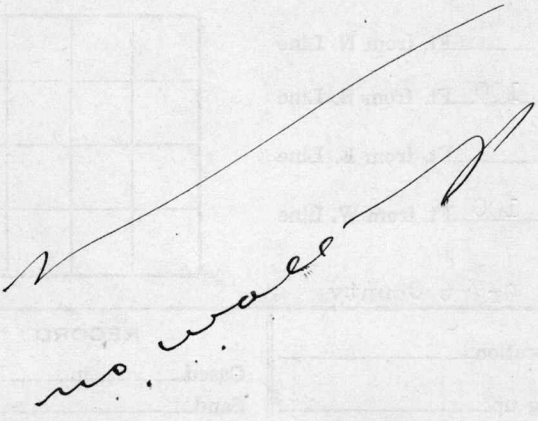

Misc. Small Maps
Cards Dorothy
Tracing
France Map
Scarborough Map X
Moody Map
Geological Dept.
Moody Plat Book