

Grant


KANSAS

FORM 51 5M PETROL

Section 30 Township 30 Range 36W


Well No. 1 Broiller

Company Panhandle Eastern

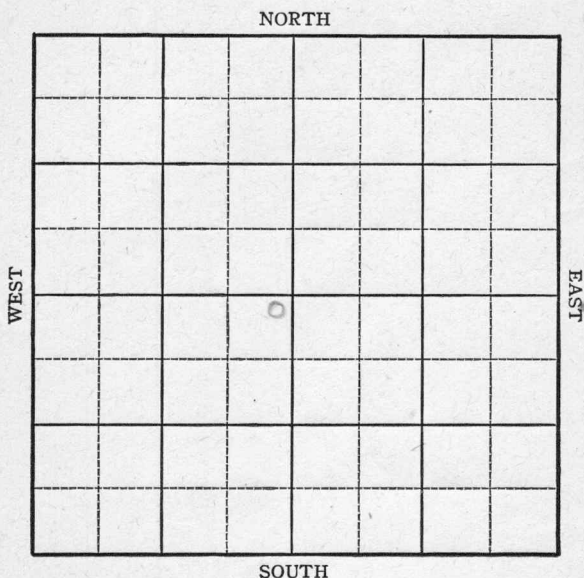

Sec. 30 Twp. 30 R. 36-WWell No. #1 Broiller Farm
Panhandle Eastern Company100 Ft. from N. Line~~100~~ Ft. from S. Line100 Ft. from E. Line Ft. from W. Line

NE SW

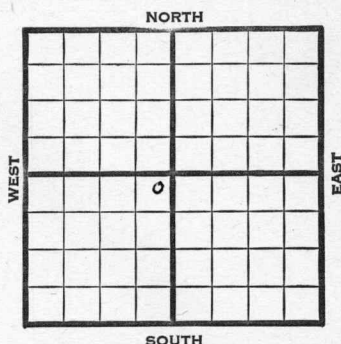

1945 Elev. 3038 REPORT

8/1 RUR

8/8 10" @ 548
Drlg. 17788/15 TD 2470
7" @ 2403' RUST

8/22 Drlg. 2515

8/29 Drlg. 2570

9/5 Drlg. 2675 2 M Gas

9/12 TD 2718
1,900,000 Gas

9;19 Drlg. 2788'

9/26 TD 2906 SW
PB

10/3 " " "

10/10 " " "

10/17 " " "

10/24 " " "

10/31 " " "

11/7 " " "

11/14 " " "

11/21 " " "

11/28 " " "

12/5 " " "

12/12 " " "

12/20 " " "

12/29 " " "

1946 " " "

1/10 " " "

1/17 " " "

1/24 " " "

OVER

1946
1/31 T.D. 2906' SW
Plugging back.

2/7	"	"
2/14	"	"
2/21	"	"
2/28	"	"
3/7	"	"

3/13 7" @ 2463
PB 2644
12,500 acid.
TD 2906'
8,700,000 Gas.
409 # R Pr.

COMPLETED

KANSAS

Kans Pool Name HugotonMap No. no map Sec. 30 Twp. 30 R. 36WWell No. 1 BroillerPanhandle Eastern

Company

FIRST REPORT

Contractor

NE SW

E 13088

SECTION PLAT

100 Ft. from N. Line100 Ft. from S. Line100 Ft. from E. Line Ft. from W. Line

Grant County

Location

Rig up

Drilling and Remarks:

RUR

RECORD

Cased in., ft.~~Sand~~

Gas

Oil

Total Depth

PRODUCTION

1st 24 hrs. Nat.

1st 24 hrs. after shot

Gas Cu. Ft.

Dry Hole

Abandoned

Date


AUG 1 1945

19

S. J. LEWIS

Scout

check Feet measurements
+ the spot
admit
Sam

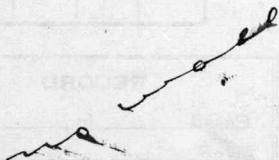

Misc. Small Maps	
Cards	<i>Baet</i>
Tracing	
France Map	<i>X</i>
Scarborough Map	<i>X</i>
Pierce Map	
Geological Dept.	
Pierce Plat Book	


KANSAS Kansas Pool Name HugotonMap No. 10 map Sec. 30 Twp. 30 R. 36WWell No. 1 BroillerPanhandle Eastern

Company

COMPLETED

Contractor

NE SW

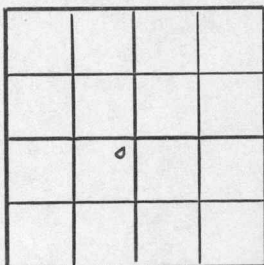E 1.3050
SECTION PLAT100 Ft. from N. Line Ft. from S. Line100 Ft. from E. Line Ft. from W. Line

Grant County

Location Rig up

Drilling and Remarks:

7" @ 2463PB 264412500 acid8,700,000 Gas409 # R/B

RECORD

Cased in., ft.Sand Gas Oil Total Depth 2906

PRODUCTION

1st 24 hrs. Nat. 1st 24 hrs. after shot Gas Cu. Ft.Dry Hole Abandoned

Date

MAR 13 1946

19

S. J. LEWIS

Scout

Misc. Small Maps _____
 Cards _____
 Tracing _____
 France Map _____
 Scarborough Map _____
 Pierce Map _____
 Geological Dept. _____
 Pierce Plat Book _____