


Section 30 Township 30 Range 4-W

Well No. 1 Miles

Company Cononial

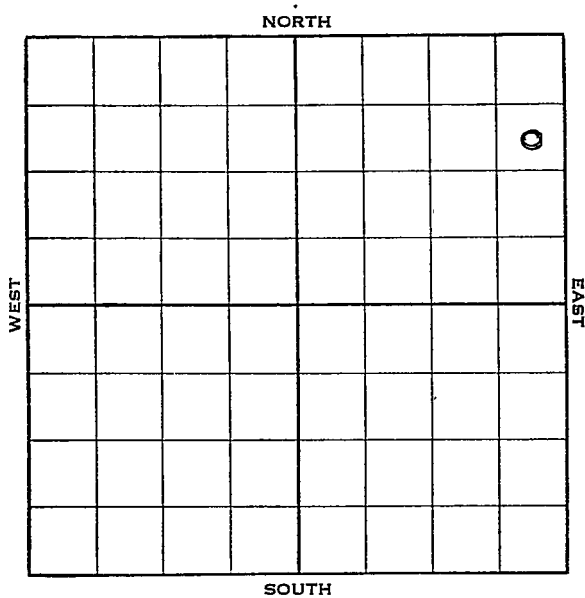

Sec. 30 Twp. 30 R. 4-W

Well No. #1 Miles Farm
Colonial Company


990 Ft. from N. Line

_____ Ft. from S. Line

330 Ft. from E. Line

_____ Ft. from W. Line

Elev. 1488

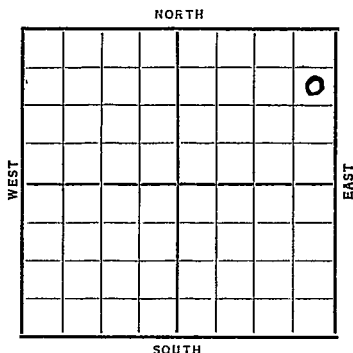

Date	REPORT
1938	
2/16	Mat'l.
2/26	"
3/4	B.R.R.
3/11	R. R.
3/18	"
3/25	"
4/1	"
4/8	"
4/15	"
4/22	R U R
4/29	12" @ 144'.
	WOC.
5/6	Drlg. 2160'.
5/12	Topeka 2621'.
	Drlg. 3585'.
5/18	K. C. 3564'.
	T.D. 3616'.
	No shows.
ABANDONED	

Map No. 37 Sec. 30 Twp. 30 R. 4WWell No. 1 MilesColonial Company

Contractor

FIRST REPORT

SE NE NE

990 Ft. from N. Line

_____ Ft. from S. Line

330 Ft. from E. Line

_____ Ft. from W. Line

SECTION PLAT

			0

Location _____

Rig up _____

Drilling and Remarks:

Matl .

RECORD

Cased _____ in., _____ ft.

Sand _____

Gas _____

Oil _____

Total Depth _____

PRODUCTION

1st 24 hrs. Nat. _____

1st 24 hrs. after shot _____

Gas _____ Cu. Ft.

Dry Hole _____

Abandoned _____

Date

FEB 16 1938

19

H. D. Hatfield

Scout

Map No. 37 Sec. 30 Twp. 30 R. 4W

Well No. 1 Miles

Colonial

Company

Contractor

ABANDONED

SE NE NE

990 Ft. from N. Line

_____ Ft. from S. Line

330 Ft. from E. Line

_____ Ft. from W. Line

SECTION PLAT

			0

Location _____

Rig up _____

Drilling and Remarks:

No shows

D & A

RECORD

Cased _____ in., _____ ft.

Sand *KC 3564*

Gas _____

Oil _____

Total Depth *3616*

PRODUCTION

1st 24 hrs. Nat. _____

1st 24 hrs. after shot _____

Gas _____ Cu. Ft.

Dry Hole _____

Abandoned _____

Date

MAY 18 1938 19

H. D. Hatfield Scout