Kingman KANSAS

SECTION 30 TOWNSHIP 30 RANGE 7W

WELL NO. #1-3 Aldrich

COMPANY Beardmore Drlg.

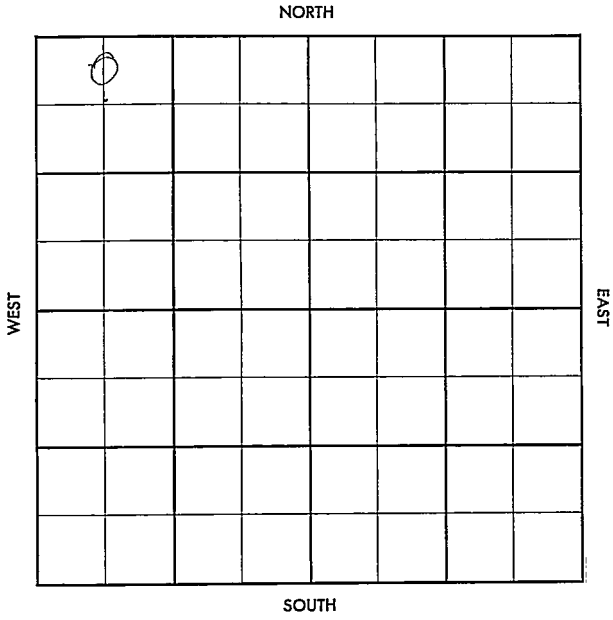

FORM 513 SUNRAY

County Kingman Elev.

Sec. 30 Twp. 30 Rge. 7W

Company Beardmore Drlg.

Farm Name Aldrich No. 1

TOPS	DEPTH	LOG	DATUM
Anh.			
T.			
H.			
Tr.			
Dg.			
B.L.			
L.			
K.C.			
B.K.C.			
Ce.			
C.			
M.			
M.			
K.			
Mz.			
Mo.			
V.			
S.			
S.			
A			
R.			
P€.			
G.			
T.D.		Spx	

Loc. in Sec. C N½ NW NW

Geol.

Contr. Co. tools

Pool Spivey-Grabs

JAN 3 '57

FIRST REPORT

3/8 mile

Date Comm.

Location

Co. Lse. No. Sec. T. R.

CORRECTION

FORM 513 SUNRAY

County Kingman Elev. 1590

Sec. 30 Twp. 30 Rge. 7W

Company Beardmore Drlg.

[redacted] Aldrich No. 3-1

[redacted]OPS	DEPTH	LOG	DATUM
Ank.			
Tp.			
H.			
Tr.			
Dg. sd	3387		
Bl.			
L.			
K.C.			
B.K.C.			
Ce.			
C.			
M.	4280		
M.			
K.			
Mz.			
Mq.			
V.			
S.			
S.			
A			
R.			
P€.			
G.			
T.D.	4345		

Loc. in Sec. C N½ NW NW

Geol.

Contr. Co. tools

Pool Spivey-Grabs

JAN 13 '57

COMPLETE

3/8 mile

Date Comm.

Location JAN 9 '57 JAN 1 '57 1-12-57

8 5/8 204/120 Ø 1865 JAN 4 '57

Ø 4180 JAN 30 '57 DST 4283-4314

1hr G/20" TSTM rec 180'

GCM + 550 + 90' GCM IBHP

1315 FBHP 515/20 FP 105-105

DST 4328-45 1hr 120' GCM + Tr. oil

+ 60' GCM + 30' O & GCM + 45' MW

IBHP 1630 FBHP 885/20 FP 45-60

5½ @ 4328/75 MICT CO

Co. Lse. No. Sec. T. R.

FORM 513-1 SUNRAY

JUL 3 '57 CO 4345 Frac '8
11 BFph 60% wtr 7 hrs.
T.P. FEB 13 '57 P.P. FEB 20 '57 P. 96
Bo + 85 Bw 24 hrs FEB 27 57'
MAR 13 '57
P P 73 BO PD + 60% Wtr

30-30-7W CN/2 NW/4