


Section 31 Township 30 Range 13-W

Well No. #2 Marjorie

Company Phillips

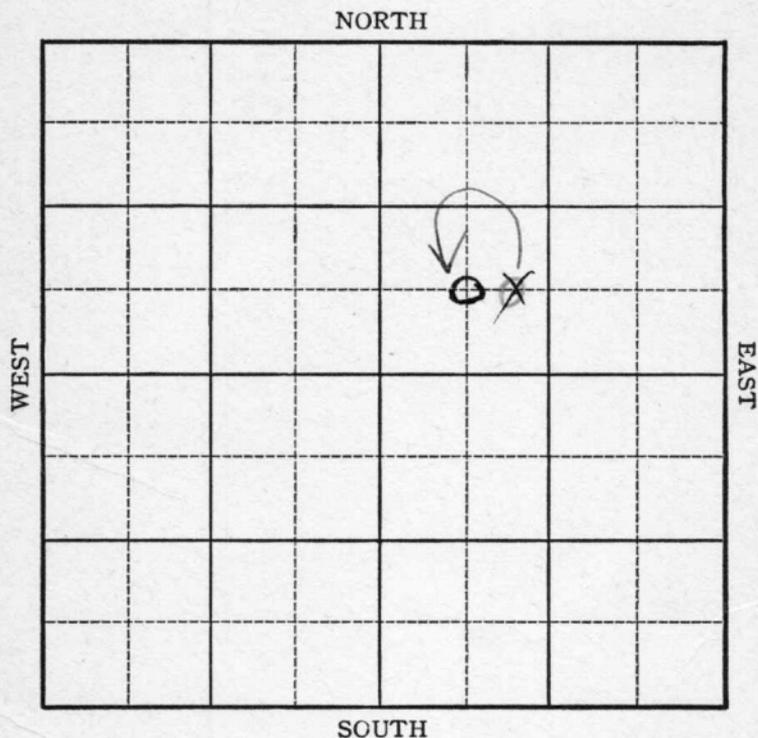



Sec. 31 Twp. 30 R. 13W

Well No. #2 Marjorie Farm

Phillips

Company

Marjorie pool


_____ Ft. from N. Line

660 Ft. from S. Line

_____ Ft. from E. Line

660
990 Ft. from W. Line

SW NE

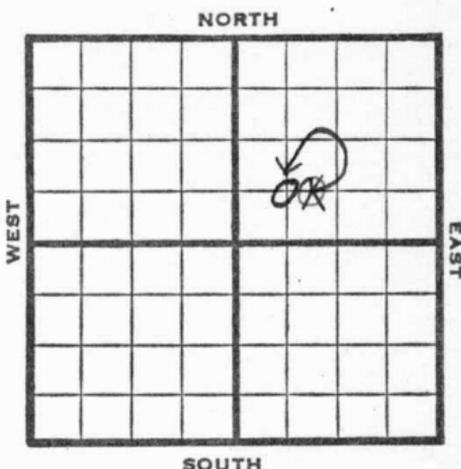

Elev. 1835 REPORT

1946

- 1/23 RUR
- 1/31 Anhy 744' 8" - 830'
Drlg. 2350'
- 2/7 Drlg. 3224'
- 2/14 Lans. 3938' Drlg. 4140'
- 2/21 Miss 4435' Kind 4467'
Magu 4522' T.D. 4540' 5" - 4539'
RUST.
- 2/28 T.D. 4540' 5" - 4539' RUST.
- 3/7 T.D. 4550 $\frac{1}{2}$ ' 24 shots 4525-30
2000 acid. 3 $\frac{1}{2}$ M gas.
- 3/14 23 shots 4530-35'
24 " 4520-25' 500 acid.
5 $\frac{1}{2}$ M gas.
- 3/20 Maguoketa 4522
5" @ 4539
7000 acid.
TD 4550 $\frac{1}{2}$
7,120,000 Gas.
1196# R Pr.

COMPLETED

KANSAS Kansas Pool Name Marjorie

Map No. 92 Sec. 31 Twp. 30 R. 13 W

Well No. 2 Marjorie

Phillips Company

FIRST REPORT

Contractor

C E L S W N E

SECTION PLAT

 Ft. from N. Line

660 Ft. from S. Line

 Ft. from E. Line

990 Ft. from W. Line

		0	

Barber County

Location

Rig up

Drilling and Remarks:

RUR

RECORD

Cased in., ft.

Sand

Gas

Oil

Total Depth

PRODUCTION

1st 24 hrs. Nat.

1st 24 hrs. after shot

Gas Cu. Ft.

Dry Hole

Abandoned

Date

JAN 23 1946 19

S. J. LEWIS Scout

1885

30

30


31

William S. Hartgrove

Phillips

C. E. S. W. NE

SECTION PLAT

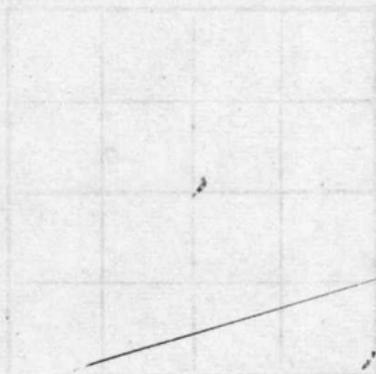

ft from N. line

200

ft from S. line

ft from E. line

200

ft from W. line

Barber County

RECORD

Grade

Sand

Gas

Location

High

Drilling and Remarks

R.R.

Misc. Small Maps

Cards

Tracing

France Map

Scarborough Map

Moody Map

Geological Dept.

Moody Plat Book

Sarahy
27

KANSAS Kansas Pool Name Marjorie

Map No. 92 Sec. 31 Twp. 30 R. 13W

Well No. 2 Marjorie

Phillips Company

CORRECTION Contractor

C SW NE

SECTION PLAT

		o	

 Ft. from N. Line

660 Ft. from S. Line

 Ft. from E. Line

660 Ft. from W. Line

Barber County

Location

Rig up

Drilling and Remarks:

reported

C E L SW NE

RECORD

Cased in., ft.

Sand

Gas

Oil

Total Depth

PRODUCTION

1st 24 hrs. Nat.

1st 24 hrs. after shot

Gas Cu. Ft.

Dry Hole

Abandoned



Date

FEB 27 1946

19

S. J. LEWIS

Scout

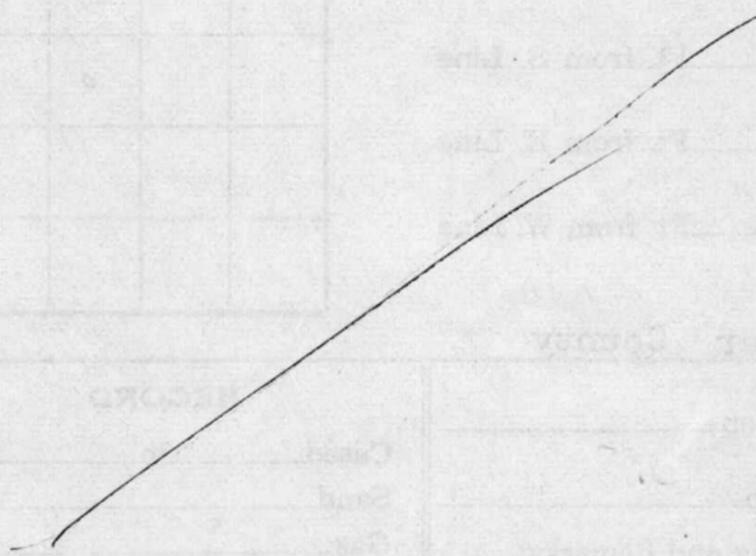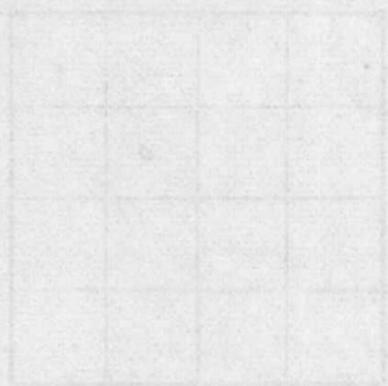

Misc. Small Maps	<i>CA</i>
Cards	<i>Saratby</i>
Tracing	<i>7</i>
France Map	<i>[Signature]</i>
Scarborough Map	<i>[Signature]</i>
Pierce Map	<i>[Signature]</i>
Geological Dept.	
Pierce Plat Desk	

KANSAS

Kansas Pool Name Skinner

Map No. 92 Sec. 31 Twp. 30 R. 13W

Well No. 2 Marjorie

Phillips Company

COMPLETED Contractor

C SW NE

E. 11885
SECTION PLAT

 Ft. from N. Line

660 Ft. from S. Line

 Ft. from E. Line

660 Ft. from W. Line

		6	

Barber County

Location

Rig up

Drilling and Remarks:

*Nequrkete 4522
5" 64589
7000000
7,120,000 Gas*

RECORD

Cased in., ft.

Sand

Gas

Oil

Total Depth 4530 1/2

PRODUCTION

1st 24 hrs. Nat.

1st 24 hrs. after shot

Gas Cu. Ft.

Dry Hole

Abandoned

1196 # R2

Date

MAR 20 1946 19

S. J. LEWIS

Scout

Misc. Small Maps *CH*
 Cards *Sarah*
 Tracing *7*
 France Map *7*
 Scarborough Map *7*
 Pierce Map *7*
 Geological Dept. _____
 Pierce Plat Book _____