


Kingman

KANSAS

SECTION 31 TOWNSHIP 30 RANGE 8W

WELL NO. #1 Conrady

COMPANY Superior

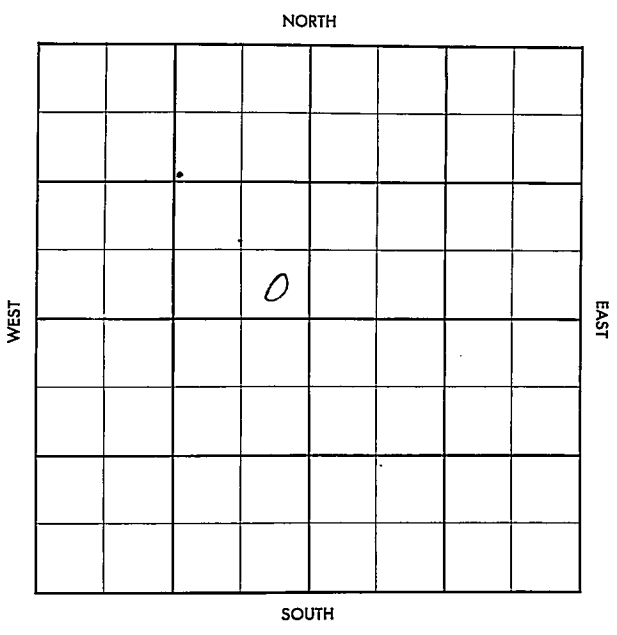

Co.

County Kingman Elev. _____
 Sec. 37 Twp. 30 Rge. 8W
 Company Superior
 Farm Name Conrady No. 1

TOPS	DEPTH	LOG	DATUM
Anh.			
Tp.			
H.			
Tr.			
Dg.			
Bl.			
L.			
K.C.			
B.K.C.			
Ce.			
C.			
M.			
M.			
K.			
Mz.			
Me.			
V.			
S.			
S.			
A.			
R.			
Pe.			
G.			
T.D.			

Loc. in Sec. SE SE NW
 Geol. _____
 Contr. _____
Barbour
 Pool _____
Spivey-Grabs

FIRST REPORT
 DEC 12 '96

Date Comm. M I R

~~27~~

County Kingman Elev. 1674 DF
 Sec. 31 Twp. 30 Rgs. 8W
 Company Superior
 Farm Name Conrady No. 1

TOPS	DEPTH	LOG	DATUM	Loc. in Sec.
Anh.				SE SE NW
TP.				
H.		3424		
Tr.				
Dg. <u>ground</u>		3456		
Bl.				
L.		3642		Geol.
K.C.		3918		Contr.
B.K.C.				Barbour
Ce.				
C.				
M.		4362		Pool
M. <u>chert</u>		4362		Spivey-Grabs
K.				
Mz.				
Mo.				
V.				
S.				
S.				
A.				
R.				
PE.				
G.				
TD.	4460			COMPLETE

Date Comm. M I R DEC 19 '56 12-13-56 10 3/4
311/250 17.2358 DEC 26 '56 10 4170
JAN 2 '57 5 1/2 @ 4460 CO 4410 96/
4384-96 9a. 621 MCFG
Killing well JAN 10 '57 9a 1.630
MCF + spray sw Flwd 4.
B dist + 2 B SW ad + 9a 1.160
MCF F10C 3x3 Flwd 1.510
MCFG 18/64" ch S.L. JAN 16 '57 9a 1.230
JAN 30 '57