Kingman KANSAS

SECTION 31 TOWNSHIP 30 RANGE 8W

WELL NO. #2 Messenger "A"

COMPANY Pickrell Drlg.

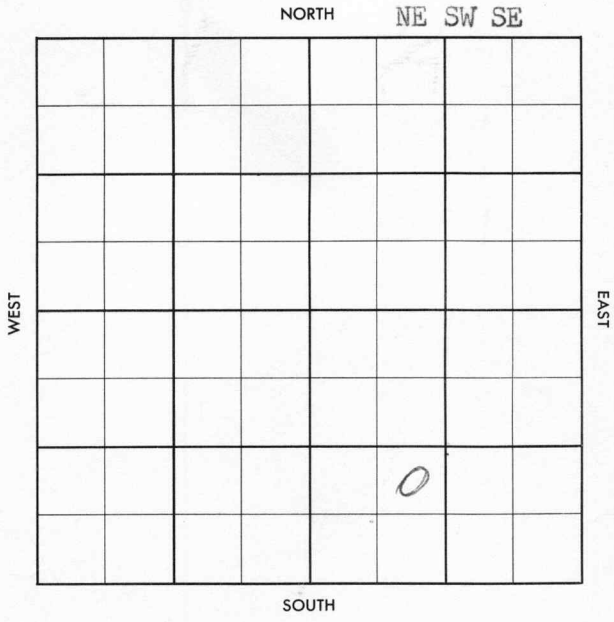

FORM 504-3 SUNRAY

8W

FORM 513 SUNRAY

County Kingman Elev.

Sec. 31 Twp. 30 Rge. 8W

Company Pickrell Drlg.

Farm Name Messenger "A" No. 2

TOPS	DEPTH	LOG	DATUM
Anh.			
Tp.			
H.			
Tr.			
Dg.			
Bl.			
L.			
K.C.			
B.K.C.			
Ce.			
C.			
M.			
M.			
K.			
Mz.			
Mq.			
V.			
S.			
S.			
A			
R.			
P€.			
G.			
T.D.			

Loc. in Sec. NE SW SE

Geol.

Contr. Co. tools

Pool Spivey-Grabs

FIRST REPORT SEP 11 57

0

Date Comm. 9-7-57

8" @ 200/150 drlg. 2300

Co. Lse. No. Sec. T. R.

27

FORM 513 SUNRAY

County Kingman Elev. Co.

Sec. 31 Twp. 30 Rge. 8W

Company Pickrell Drlg.

Farm Name Messenger "A" No. 2

TOPS	DEPTH	LOG	DATUM
Anh.			
Tp.			
H.			
Tr.			
Dg.			
B.L.			
L.			
K.C.			
B.K.C.			
Ce.			
C.			
M.	4338		
M.			
K.			
Mz.			
Mo.			
V.			
S.			
S.			
A			
R.			
Pe.			
G.			
T.D.	4448		

Loc. in Sec. NE SW SE

Geol.

Contr. Co. tools

Lse.

Pool Spivey-Grabs

COMPLETE

DEC 11 '57

0

No.

Date Comm. 9-7-57

Sec.

8" @ 200/150 drlg. 2300 Ø 4122

SEP 25 '57 DST 4342-65 1½ hr

T.

G/9" TSTM 110' GCM BHP

1197/20" PST 4370-4405 1½ hr

G/16" 120' SOCM 500 MCO

30 Mdw BHP 1725/20

R.

5" 4447 CO 4426 80/4370-90

OCT 2 '57 Flo 125 BO no W

12 hr SI 39/64 Ck GOR 1080-1

OCT 9 '57 OCT 16 '57

FORM 513-1 SUNRAY

OCT 23 '57 OCT 30 '57 NOV 6 '57 NOV 13 '57 NOV 20 '57
NOV 27 '57 DEC 4 '57 DEC 11 '57

State Test

FIO 19180 NW PA
GOX 320-1

31-30-8W NE SW SE