


Section 31 Township 30 Range 33-W

Well No. #1 Thompson "B"

Company Cities Service

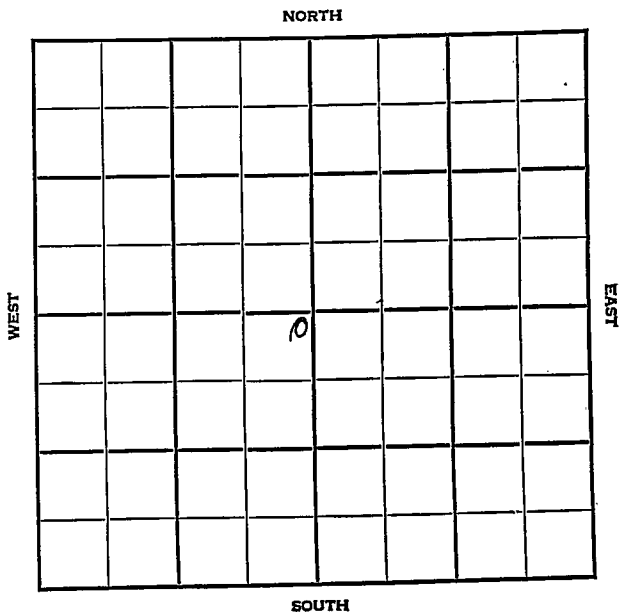

Sec. 31 Twp. 30 R. 33W

Well No. #1 Thompson "B" Farm

Cities Service Company


Hugoton Pool

100' Ft. from N. Line

\_\_\_\_\_ Ft. from S. Line

100' Ft. from E. Line

\_\_\_\_\_ Ft. from W. Line

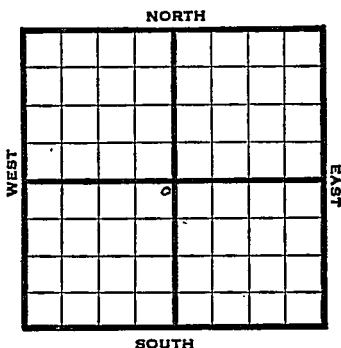

NE SW

1948 E<sub>1</sub>i 2950' REPORT

6/16	Location	
6/23	8" @ 640'	
	Drlg. 1590'	
6/29	TD 2765'	
	5" @ 2764'	
	RUST	
7/8	"	
7/14	"	
7/21	220 shots 2788-52	9000 acid
	110 shots 2662-84	
	140 shots 2620-48	
	70 shts 2596-2610	14,000 acid
7/28	"	"
8/4	9000 acid.	
8/11	"	
8/18	"	
8/25	5" @ 2764'	
	TD 2765'	
	Perf 32000 acid	
	10,100,000 gas	
	420# R PR.	

omp  
**COMPLETED**

Map No. \_\_\_\_\_ Sec. 31 Twp. 30 R. 33W

Well No. 1 Thompson "B"

Cities Service Company

**FIRST REPORT** Contractor

NE SV

SECTION PLAT

100 Ft. from N. Line

\_\_\_\_\_ Ft. from S. Line

100 Ft. from E. Line

\_\_\_\_\_ Ft. from W. Line


Haskell County

Location X

Rig up \_\_\_\_\_

Drilling and Remarks:

RECORD

Cased \_\_\_\_\_ in., \_\_\_\_\_ ft.

Sand \_\_\_\_\_

Gas \_\_\_\_\_

Oil \_\_\_\_\_

Total Depth \_\_\_\_\_

PRODUCTION

1st 24 hrs: Nat. \_\_\_\_\_

1st 24 hrs: after shot \_\_\_\_\_

Gas \_\_\_\_\_ Cu. Ft.

Dry Hole \_\_\_\_\_

Abandoned \_\_\_\_\_

Date

JUN 16 1948 19\_\_\_\_\_

S. J. LEWIS Scout

Haskell County Kansas State

Map No. \_\_\_\_\_ Sec. 31 Twp. 30 R. 33W

Well No. 1 Thompson "B"

Cities Service Company

**COMPLETE** Contractor

NE SW

*E 1,295*  
SECTION PLAT

100 Ft. from N. Line

\_\_\_\_\_ Ft. from S. Line

100 Ft. from E. Line

\_\_\_\_\_ Ft. from W. Line

			0				

Hugoton Pool

Remarks:

*5102764*

*7152765*

*Prof*

*32000 acid*

*10,100,000 Gall*

*420 \* R/R*

Date  
AUG 25 1948

Scout  
S. J. LEWIS