Kingman **KANSAS**

SECTION 31 TOWNSHIP 30 RANGE 7W

WELL NO. #1 Valdois

COMPANY Anschutz

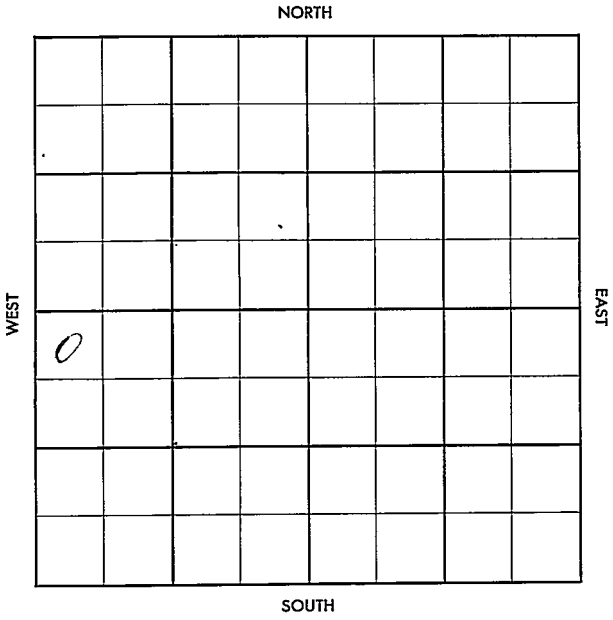

HOT FILE

Kingman KANSAS

SEC.	TWP.	R.
31	30 S	7 W

WELL NO.

1 Valdois FARM

COMPANY

Anschutz Drlg. Co. Inc.

CONTRACTOR

G. M. Tools

Wildcat

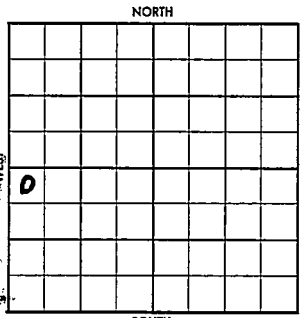

_____ FT. FROM N. LINE

_____ FT. FROM S. LINE

_____ FT. FROM E. LINE

_____ FT. FROM W. LINE

NORTH

WEST 0 EAST

SOUTH

NW NW SW

SDX-DHC-$3000.00 (Lse S-21957 & A)

Magnolia FO

Donat advise Cont. Section

1956	ELEVATION 1652' KB REPORT (WH6-DC61)
8/27	Mississippi formation appx 4400' To commence by October 1, 1956 To complete by November 1, 1956. (See DHC Agreement 8/27/56)
9/26	Spud 9-21-56 8" @ 205 w/150 Drlg. 2980' (FR Tkt)
10/3	Spud 9-21-56 8" @ 205 w/150 Drlg. 2980' D & A TD 4469' Tops: H. 3360', Dg. 3396', L. 3596', KC 3847' Log tops: H. 3361', Dg. 3409', L. 3596' KC 3852'. BKC 4122' M. 4374' TD 4469' D & A (Sct. Comp. Tkt)

ABANDONED

FORM 504-5 SUNRAY

FORM 513 SUNRAY

County Kingman Elev.

Sec. 31 Twp. 30 Rge. 7W

Company Anschutz

FarmName Valdois No. 1

TOPS	DEPTH	LOG	DATUM
Anh.			
Tp.			
H.			
Tr.			
Dg.			
B.L.			
L.			
K.C.			
B.K.C.			
Ce.			
C.			
M.			
M.			
K.			
Mz.			
Mo.			
V.			
S.			
S.			
A			
R.			
P€.			
G.			
T.D.			

Loc. in Sec. NW NW SW

Geol.

Contr. G. M. Tools

Pool SPIVEY

Wildcat Tools

SEP 26 '56

FIRST REPORT

Date Comm. spd. 9-21-56 Magnolia (FO) Sun. DHM

8" @ 205 w/150, Drlg 2980

Co. Lse. No. Sec. T. R.

FORM 513 SUNRAY

County: Kingman Elev. 1652 KB

31 T. 30 Rge. 7W

Maschutz

Valdcis No. 1

TOPS	DEPTH	LOG	DATUM
Anh.			
T.P.			
H.	3360	3361	
Tr.			
Dg.	3396	3409	
Bl.			
L.	3596	3596	
K.C.	3847	3852	
B.K.C.		4122	
Ce.			
C.			
M.		4374	
M.			
K.			
Mz.			
Mq.			
V.			
S.	D & A		
S.			
A			
R.			
P€.			
G.			
T.D.	4469		

Loc. in Sec. NW NW SW

Geol.

Contr. C. E. Tools

Pool SPIVEY

Wildcat

ABANDONED

OCT 3 '56

Date Comm. spd. 9-21-56 Magnolia (FO) Sun. DHM

8⅝" @ 205 w/150, Drlg 2980 OCT 3 '56

Co. Lse. No. Sec. T. R.