


Section 31 Township 30 Range 37W

Well No. #1-31 Tuttle

Company Hugoton Prod.

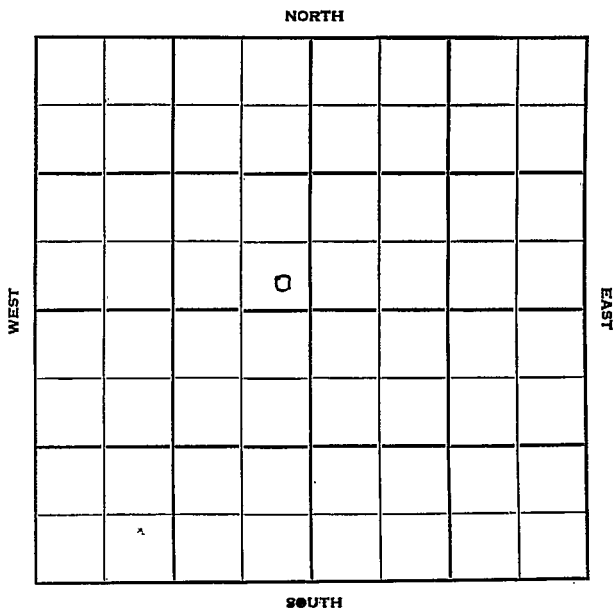

Grant

KANSAS

Sec. 31 Twp. 30 R. 37W

Well No. #1-31 Tuttle Farm

Hugoton Prod. Company

Moran - Contr. Contractor

Hugoton


Ft. from N. Line

200' Ft. from S. Line

200' Ft. from E. Line

Ft. from W. Line

SE SE NW

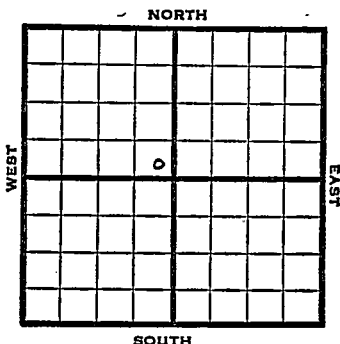

1951

Elev. 3065' REPORT

11/14

Location

1952

1/16

Spud 11-16-51

Gas well TD 2630' 10" @ 518

7" @ 2409 TD 2630' Hol. 2355'

Her. 2405' Kr. 2424' Win. 2483'

Ft. Riley 2541' 6000 A

Comp. 21,000,000 gas

COMPLETED

County Grant State Kansas
 Sec. 31 (Blk.) 30 (Sur.) 37W Map No.
 Operator Hugoton Prod.
 Well No. 1-31 Farm Tuttle
 Elev. _____ Location SE SE NW

0

FIRST REPORT

200 Ft. From S Line NW

200 Ft. From E Line Quarter

Ist. Report NOV 14 1951

Completion _____

Remarks _____


Moran - Contr.

Spudding Date _____

Drlg. Data Hugoton

Location

J. E. TYER

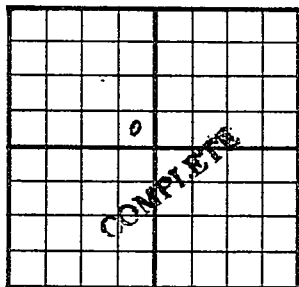County Grant State KansasSec. 31 (Blk. Twp.) 30 (Sur. Rge.) 37W Map No. _____Operator Hugoton Prod.Well No. 1-3 farm TuttleElev. 3065 Location SE SE NW200 Ft. From S Line NW200 Ft. From E Line Quarter

1st. Report _____

Completion JAN 16 1952Remarks Hugoton PoolMoran - Contr.Spudding Date 11-16-51Drlg. Data Gas well TD 263010" @ 518 7" @ 2409 TD 2630Hol. 2355 Her. 2405 Kri. 2424Win. 2483 Ft. Riley 2541 6000 AComp. 21,000,000 gas

J. E. TYRA