


Company Stanolind

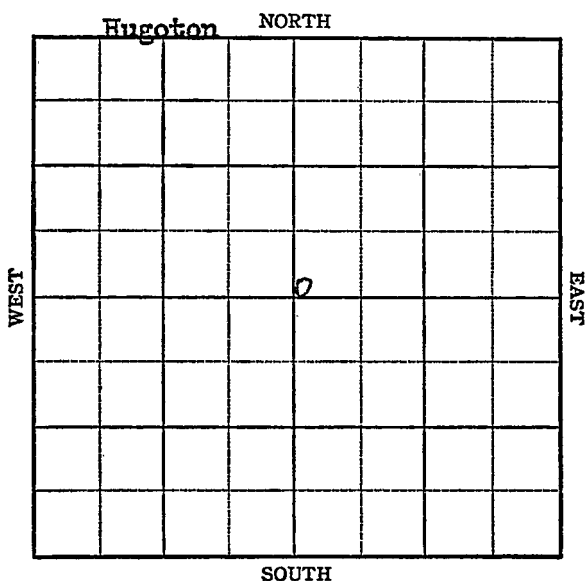

Sec. 31 **KANSAS**

Twp. 30

R. 38W

Well No. # Pirtle Farm
Stanolind Company

Hugoton

Ft. from N. Line

50


Ft. from S. Line

Ft. from E. Line

50

Ft. from W. Line

SW NE

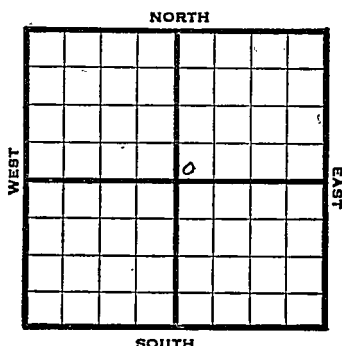

1947 Elev. 3155' REPORT

9/10 9" @ 556
drlg. 1973

9/17 TD 2430'
7" @ 2427'

9/24 "

10/1 Drlg. 2585'

10/8 7" @ 2427'
237' of 5" Perf liner @ 2646
15,000 acid
8,175,000 Gas
400# R Pr.
TD 2646'

COMPLETED

Map No. _____ Sec. 31 Twp. 30 R. 38W

Well No. 1 Pirtle

Stanolind Company

FIRST REPORT

Contractor

SW NE


SECTION PLAT

_____ Ft. from N. Line

50 Ft. from S. Line

_____ Ft. from E. Line

50 Ft. from W. Line

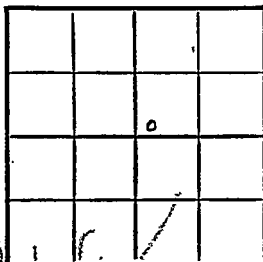

Grant County

Location _____

Rig up _____

Drilling and Remarks:

9" @ 556

drlg. 1973

RECORD

Cased _____ in, _____ ft.

Sand _____

Gas _____

Oil _____

Total Depth _____

PRODUCTION

1st 24 hrs. Nat. _____

1st 24 hrs. after shot _____

Gas _____ Cu. Ft.

Dry Hole _____

Abandoned _____

Date

SEP 10 1947

19

S. J. LEWIS

Scout

Map No. 0 Sec. 31 Twp. 30 R. 38W

Well No. 1 Pirtle

Stanolind Company

COMPLETE

Contractor

SW NE

F13155
SECTION PLAT

 Ft. from N. Line

50 Ft. from S. Line

 Ft. from E. Line

50 Ft. from W. Line

		6	

Grant County

Location

Rig up

Drilling and Remarks:

7" 02427
287' 5" Pay liner
@ 2646
15000 acc'd
5,175,000 Gas
400# R/P

RECORD

Cased in., ft.

Sand

Gas

Oil

Total Depth 2646

PRODUCTION

1st 24 hrs. Nat.

1st 24 hrs. after shot

Gas Cu. Ft.

Dry Hole

Abandoned

Date

OCT 8 1947

19

S. J. LEWIS

Scout