


KANSAS

Stanton county

Section 31 Township 30 Range 39-W

Well No. #1, Dietz

Company Stanolind Oil and Gas Company

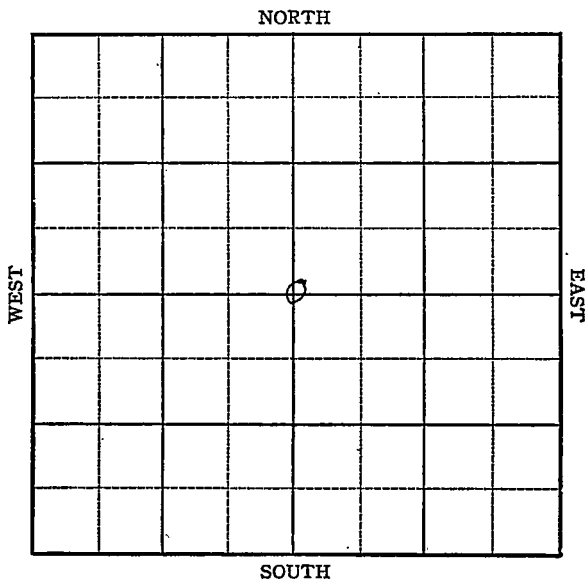


Sec. 31 Twp. 30 R. 39-WWell No #1, Dietz FarmStanolind Oil and Gas Company CompanyHugoton2640' Ft. from N. Line

Ft. from S. Line

2640' Ft. from E. Line

Ft. from W. Line

C Sec.

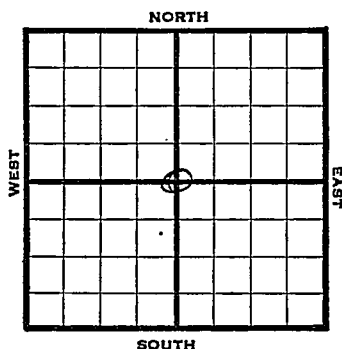

1946

Elev. 3238'

REPORT

10/2 Surface hole.

10/8 TD 2590'
Run csg10/15 TD 2590
5" @ 2546 RUST

10/22 " "

10/29 60 shots-2517-27 CO

11/6 8500 acid
48 shots 2536-44

11/12 246 shots 2394-2470'

11/20 " " "

11/27 W sqz Peff 2394-2418'

12/3 " "

12/11 5" @ 2546'
TD 2590'
Pe rf
18000 Acid
3,671,000 Gas**COMPLETED**

KANSAS Kansas Pool Name HugotonMap No. _____ Sec. 31 Twp. 30 R. 39WWell No. 1 DietzStanolind Company

FIRST REPORT

Contractor _____

C Sec.


2640 Ft. from N. Line

_____ Ft. from S. Line

2640 Ft. from E. Line

_____ Ft. from W. Line

SECTION PLAT

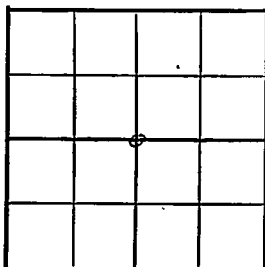Stanton County

Location _____

Rig up _____

Drilling and Remarks:

surface hole

RECORD

Cased _____ in., _____ ft.

Sand _____

Gas _____

Oil _____

Total Depth _____

PRODUCTION

1st 24 hrs. Nat. _____

1st 24 hrs. after shot _____

Gas _____ Cu. Ft.

Dry Hole _____

Abandoned _____

Date

OCT 2 1946 19S. J. LEWIS Scout

Map No. _____ Sec. 31 Twp. 30 R. 39WWell No. 1 Dietz

Stanolind _____ Company

COMPLETED

Contractor

C Sec.

E1,3238


SECTION PLAT

2640 Ft. from N. Line

_____ Ft. from S. Line

2640 Ft. from E. Line

_____ Ft. from W. Line

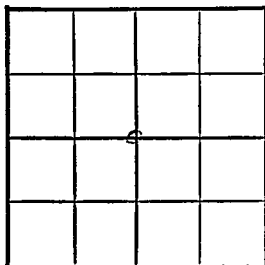

Stanton County

Location _____

Rig up _____

Drilling and Remarks:

5" C2576
Perf.
18000 acid
3,671,000 Gas

RECORD

Cased _____ in., _____ ft.

Sand _____

Gas _____

Oil _____

Total Depth 2590

PRODUCTION

1st 24 hrs. Nat. _____

1st 24 hrs. after shot _____

Gas _____ Cu. Ft.

Dry Hole _____

Abandoned _____

Date

DEC 1 1 1946

19

S. J. LEWIS

Scout