

STATE CORPORATION COMMISSION OF KANSAS
OIL & GAS CONSERVATION DIVISION
WELL COMPLETION OR RECOMPLETION FORM
ACO-1 WELL HISTORY
DESCRIPTION OF WELL AND LEASE

Operator: License # 5363
Name * BEREXCO INC.
Address 970 Fourth Financial Center
Wichita, KS 67202
City/State/Zip

Purchaser Central Crude

Operator Contact Person Evan C. Mayhew
Phone (316) 265-3311

Contractor: License # 5147
Name BEREDCO, Inc.

Wellsite Geologist Ross Meyer
Phone

Designate Type of Completion
☒ New Well ☐ Re-Entry

☒ Oil ☐ SWD ☐ Sp Abd
☐ Gas ☐ Inj ☐ Delayed Comp.
☐ Dry ☐ Other (Core, Water Supply etc.)

If OWWO: old well info as follows:
Operator
Well Name
Comp. Date Old Total Depth

WELL HISTORY

Drilling Method:
☒ Mud Rotary ☐ Air Rotary ☐ Cable

8-16-88 8-30-88 10-7-88
Spud Date Date Reached TD Completion Date
5790' 5061'
Total Depth PSTD

Amount of Surface Pipe Set and Cemented at 1853 feet
Multiple Stage Cementing Collar Used? ☒ Yes ☐ No
If yes, show depth set 3304 feet
If alternate 2 completion, cement circulated
from feet depth to w/ SX cmt
Cement Company Name
Invoice #

API NO. 15-081-20,501
County Haskell
SE SW Sec 31 Twp 30S Rge 32W West
660 Ft North from Southeast Corner of Section
3300 Ft West from Southeast Corner of Section
(Note: Locate well in section plat below)


Lease Name MILLER TRUST Well # 1-31

Field Name

Producing Formation Pawnee

Elevation: Ground 2891 KB 2904

Section Plat

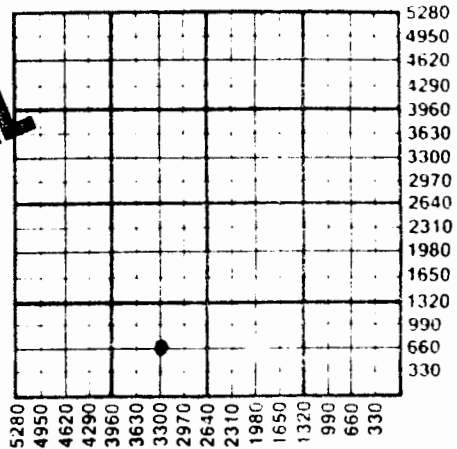

WATER SUPPLY INFORMATION

Disposition of Produced Water: ☒ Disposal
Docket # D-25,121 ☐ Repressuring
Eugene Davis #2 SWD

Questions on this portion of the ACO-1 call:

Water Resources Board (913) 296-3717

Source of Water:
Division of Water Resources Permit #

Groundwater Ft North from Southeast Corner
(Well) Ft West from Southeast Corner of
Sec Twp Rge East West

Surface Water Ft North from Southeast Corner
(Stream, pond etc) Ft West from Southeast Corner
Sec Twp Rge East West

Other (explain)
(purchased from city, R.W.D. #)

INSTRUCTIONS: This form shall be completed in duplicate and filed with the Kansas Corporation Commission, 200 Colorado Derby Building, Wichita, Kansas 67202, within 90 days after completion or recompletion of any well. Rule 82-3-130 and 82-3-107 apply.
Information on side two of this form will be held confidential for a period of 12 months if requested in writing and submitted with the form. See rule 82-3-107 for confidentiality in excess of 12 months.
One copy of all wireline logs and drillers time log shall be attached with this form. Submit CP-4 form with all plugged wells. Submit CP-111 form with all temporarily abandoned wells.

All requirements of the statutes, rules and regulations promulgated to regulate the oil and gas industry have been fully complied with and the statements herein are complete and correct to the best of my knowledge.

Signature Evan C. Mayhew
Title Engineer Date 12-8-88

Subscribed and sworn to before me this 8 day of December 1988
Notary Public
Date Commission Expires 3-20-90

K.C.C. OFFICE USE ONLY
☒ Letter of Confidentiality Attached
☒ Wireline Log Received
☒ Drillers Timelog Received
Distribution
SWD/Rep NGPA
Plug Other (Specify)
RECEIVED
KANSAS CORPORATION COMMISSION
12-15-1988
CONSERVATION DIVISION
Wichita, Kansas