


Kiowa

KANSAS

SECTION 32 TOWNSHIP 30S RANGE 18W

WELL NO. #1 Barngrover

COMPANY Sunray Mid-Continent Oil Co.

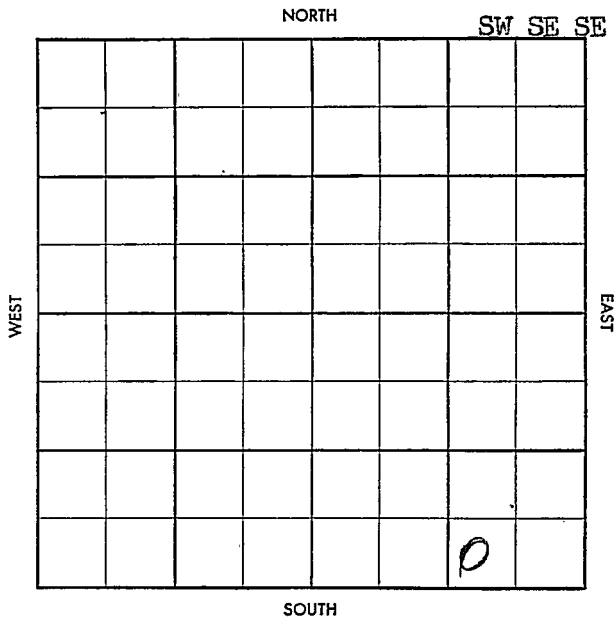

HOT FILE Kiowa KANSAS

SEC. 32	TWP. 30 S	R. 18 W
---------	-----------	---------


WELL NO. #1 Barngrover FARM

COMPANY Sunray Mid-Continent (DEVELOPMENT)

CONTRACTOR Stickle

Mule Creek Pool

_____ FT. FROM N. LINE
 330 _____ FT. FROM S. LINE
 990 _____ FT. FROM E. LINE
 _____ FT. FROM W. LINE

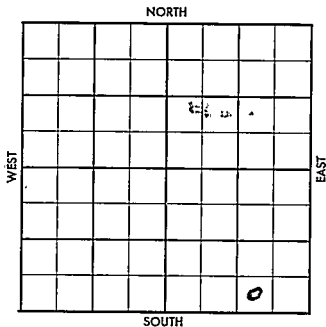

of SE/4

SW SE SE

ELEVATION	REPORT
-----------	--------

1958

5200' Miss Test

2/20 MIRT (DR#36)

2/21 Spud 2-20-58
 TD 517'. Rng. csg.

2/24 ~~XXXXXX~~ 8-5/8" csg. @ 514' cmtd. w/450'
 Drlg. 2525'

2/25 Drlg. 2810' (FR Tkt)

2/26 Drlg. 3060'

2/27 Drlg. 3465'

2/28 Drlg. 3795'

3/3 Drlg. 4410'

3/4 Drlg. 4545'

3/5 Drlg. 4660'

3/6 Drlg. 4775'

3/7 Drlg. 4874'

3/10 TD 5140' P & A (DR#48)

~~Mule Creek~~

25

S-513-B

County *Kiowa* Elev. _____

Sec. *32* Twp. *30* Rge. *18W*

Company *Sunray Mid-Continent*

Farm Name *Barngrover* No. *1*

Co. _____

Lse. _____

No. _____

Sec. _____

T. _____

R. _____

TOPS	DEPTH	LOG	DATUM
Anh.			
Tp.			
H.			
Tr.			
Dg.			
B.L.			
L.			
K.C.			
B.K.C.			
Ce.			
C.			
M.			
M.			
K.			
Mz.			
Mq.			
V.			
S.			
S.			
A.			
R.			
Pf.			
G.			
T.D.			

Loc. in Sec. _____

 SW SE SE

Geol. _____

Contr. *Stickle*

Pool *Mule Creek*

FIRST REPORT
 FEB 26 58

Date Comm. *2-20-58*

 8" @ 514/450 drlg. 2810

MAR 3 1958

AA 5A⁷

~~Mule Creek~~

S-513-B

County Iowa Elev. 2127.6 S. 7216
 Sec. 32 Twp. 30 Rge. 18W
 Company Amra Continent
amrover No. 1

	DEPTH	LOG	DATUM
Tp.	<u>X 4224</u>		<u>2.21</u>
H.			
Tr.			
Dg.			
B.L.	<u>4394</u>		<u>2.220</u>
L.	<u>4412</u>		<u>2.240</u>
K.C.			
B.K.C.	<u>4736</u>		<u>2.566</u>
Ce. <u>max</u>	<u>4850</u>		<u>2.600</u>
C.			
M.	<u>5021</u>		<u>2.901</u>
M. <u>Chart</u>	<u>5101</u>		<u>2.901</u>
K.			
Mz.			
Mq.			
V.			
S.			
S.			
A.			
R.			
Pf.			
G.			
T.D.	<u>5140</u>		

Loc. in Sec. _____
SW S. 32
 Geol. _____
 Contr. Sticile
 Pool Mule Creek

ABANDONED

MAR 12 1958

Date Comm. 2-20-58
8" @ 514/150 drls. 2"10
Ø 4545 MAR 12 1958 X TOPS DST
5094-93 60" 450' gip 120' 5 gcm NO
oil FP 75-90 IBMP 615 - FBMP 245
NO SHOW LOG

DVA

Co. No. Sec. T. R.