


Section 32 Township 30 Range 13W

Well No. 1 Gant "B"

Company Huber Oil

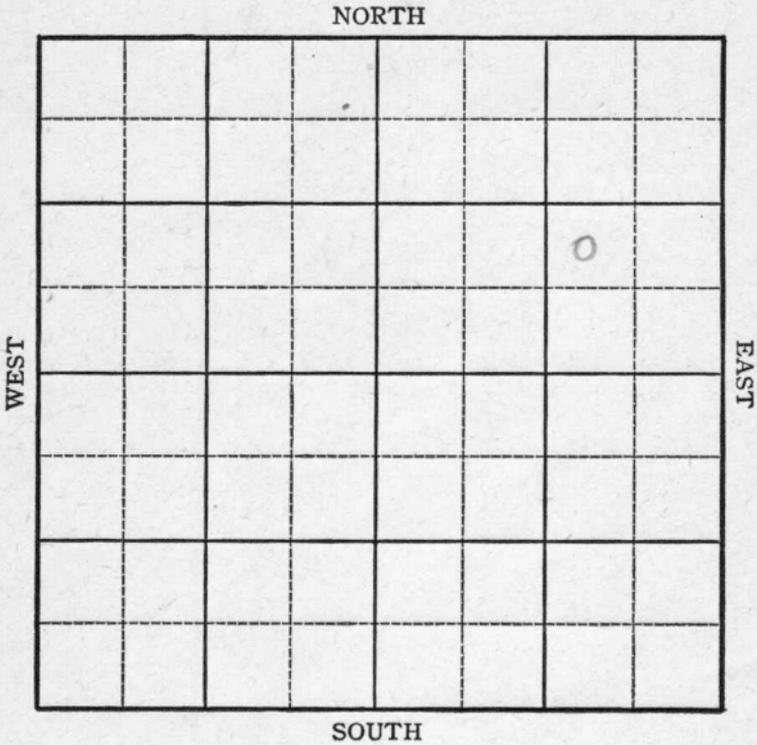

Sec. 32 Twp. 30 R. 13-W

Well No. #1 Gant "B" Farm _____


Huber Oil Company _____

_____ Ft. from N. Line

990 Ft. from S. Line

990 Ft. from E. Line

_____ Ft. from W. Line

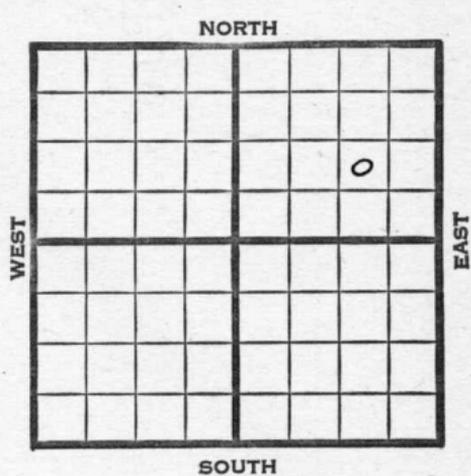

NW SE NE Elev. 1851

REPORT

1945

- 8/8 Derrick
- 8/15 10" @ 805' WOC
- 8/22 Drlg. 2400
- 8/29 Drlg. 4320
- 9/5 ~~Dans~~ 3950
Miss 4442
Magu 4554
TD 4569
5" @ 4558' RUST
- 9/12 TD 4569'
Flow 1 oil per hr. 4 hrs. $\frac{1}{2}$ M Gas
- 9/19 2000 acid.
10 M Gas. SSO
- 9/26 " " "
- 10/3 " " "
- 10/10 " " "
- 10/17 " " "
- 10/24 " " "
- 10/31 " " "
- 11/7 " " "
- 11/14 " " "
- 11/21 " " "
- 11/28 " " "
- 12/5 " " "
- 12/12 " " "
- 12/20 Flow 116 oil in $8\frac{1}{2}$ hours.
5 $\frac{1}{2}$ M gas.



OVER

1945

12/28 Maquokete 4554
5" @ 4558
2000 acid.
TD 4569
Flow 293 oil No W Pot.
5,570,000 Gas

COMPLETED

FIRST REPORT
SECTION PLAT

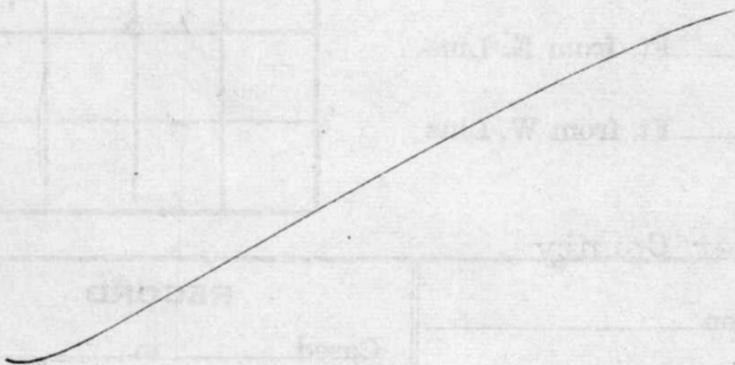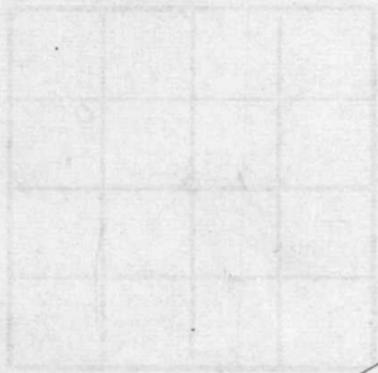

- Misc. Small Maps _____
- Cards _____ *See*
- Tracing _____ *BB*
- France Map _____ *[Signature]*
- Scarborough Map _____ *[Signature]*
- Pierce Map _____ *[Signature]*
- Geological Dept. _____
- Pierce Plat Book _____

KANSAS

Kansas Pool Name Marjorie

Map No. K-92 Sec. 32 Twp. 30 R. 13W

Well No. 1 Gant "B"

Euber Oil Company

COMPLETED

Contractor

NW SE NE

E. 1, 1851
SECTION PLAT

_____ Ft. from N. Line

990 Ft. from S. Line

990 Ft. from E. Line

_____ Ft. from W. Line

			0

Barber County

Location _____

Rig up _____

Drilling and Remarks:

*Magwopite 4557
5" C 4558
2000 acid
Flow 293 oil
No W B D.
5-579,000 gal*

RECORD

Cased _____ in., _____ ft.

Sand _____

Gas _____

Oil _____

Total Depth 4569

PRODUCTION

1st 24 hrs. Nat. _____

1st 24 hrs. after shot _____

Gas _____ Cu. Ft.

Dry Hole _____

Abandoned _____

Date

DEC 28 1945

19

S. J. LEWIS

Scout

Misc. Small Maps _____
Cards Sarathy _____
Tracing 27 _____
France Map ✓ _____
Scarborough Map ✓ _____
Pierce Map ✓ _____
Geological Dept. _____
Pierce List Book _____