


Section 32 Township 30 Range 8W

Well No. #1 Duckworth

Company Sinclair O & G

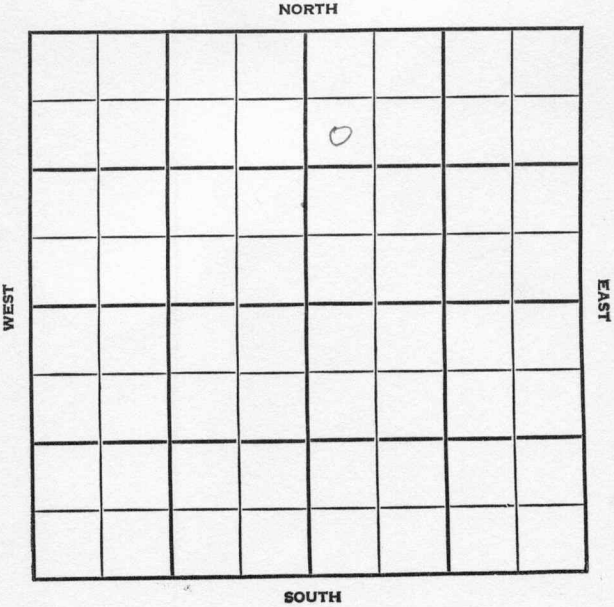

Kingman

KANSAS

SEC.

32

TWP.

30

R.

8W

WELL NO.

#1 Duckworth

FARM

COMPANY

Sinclair O & G

CONTRACTOR

Brack


Spivey

____ FT. FROM N. LINE

____ FT. FROM S. LINE

____ FT. FROM E. LINE

____ FT. FROM W. LINE

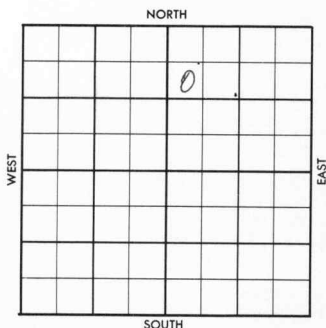~~##~~ SW NW NESDX - $\frac{1}{4}$ mile

ELEVATION

REPORT

1956

8-22

MIR

8-30

Spud 8-22-56
10 3/4" @ 276 w/250
Drlg 2338

9-7

Heeb 3332, Doug 3399, Lans 3592,
Drlg 4008

County Kingman Elev. _____
Sec. 32 Twp. 30 Rge. 8W
Company Sinclair O & G
Farm Name Duckworth No. 1

TOPS	DEPTH	LOG	DATUM
Anh.			
TP.			
H.			
Tr.			
Dg.			
BL.			
L.			
K.C.			
B.K.C.			
Ce.			
C.			
M.			
M.			
K.			
Mz.			
Mq.			
V.			
S.			
S.			
A.			
R.			
PE.			
G.			
T.D.			

Loc. in Sec. SW NW NE
Geol. _____
Contr. _____
Brack
Pool
Survey
SDX
1/4 mile
FIRST REPORT
AUG 22 '56

Date Comm. M I R

27
R.G.

County Kingman Elev. 1667
 Sec. 32 Twp. 30 Rge. 8W
Shelair O & G
Duckworth No. 1

TOPS	DEPTH	LOG	DATUM	Loc. in Sec.
Anh.				SW NW NE
Tr.	3332	3334		
Dg.	3399	3400		
BL.				
L.	3592	3593		
K.C.				Geol.
B.K.C.				Contr.
Ce.				Brack
C.				Pool
M. chert	4328	4330		Spivey
M. LI	4391			COMPLETE
K.				
Mz.				
Mo.				
V.				
S.				
S.				
A.				
R.				
Pe.				
G.				
T.D.	4460			

OCT 10 1956

Date Comm.

M I R AUG 29 '56 8-22-56 10 3/4

276/250 ID 2338 SEP 5 '56

ID 4008 SEP 12 '56 crd 4332-62 rec

30' DST 4328-62 7.5" G/8"

92 1.450 MCF 1 hr rec. 10'

GCM + 120' MSW FP 240-475

1565/30" crd 4362-82 rec

20' DST 4362-82 3 hrs G/8"

92 1.774 MCF 13 hrs rec. 180

SEP 8 '56

SGCMSW FP 205-520
 BHP-1560/30 cid 4382-92
 rec 10' DST 4381-92 1 1/2 hr
 G/22' no ga rec 95' SGCM
 FP 210-210 BHP 1635/30
 SEP 19 '56 5 1/2 @ 4460/200 GRNL
 SEP 20 '56 CO 4295 36/4331-40
 160/4345-85 1/2 Flwd
 2.564 MCF 1" ch TP 90
 CP 450 # Frac Flg Ld +
 9.545 MCFG 1" ch TP
 420 CP 1180 # OCT 3 '56 Flw Ld
 + 8.667 MCF 1" ch TP 450
 CP 1160 # OCT 10 '56 Cal op Flow
 53 Mill. CFP.