


KINGMAN

KANSAS

DX 78-1

Section 32 Township 30S Range 9W
Well No. #2 Folkes
Company Time Pet. Co.

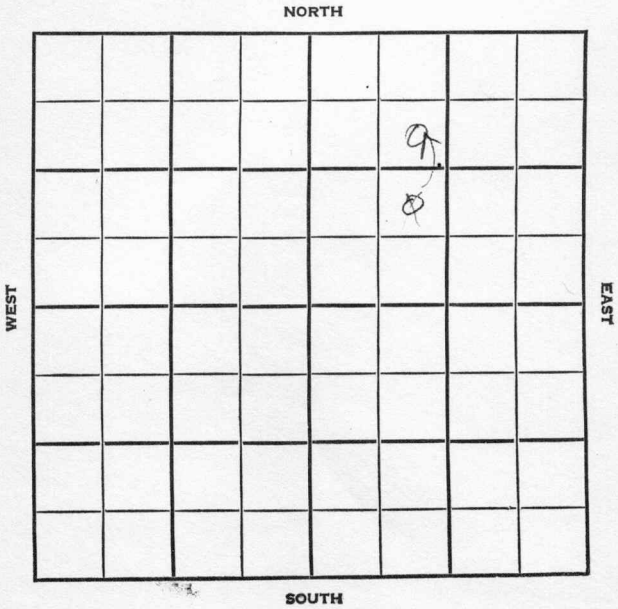

Kingman

KANSAS

SEC.

32

TWP.

30

R.

9W

WELL NO.

#2 Folkes

FARM

COMPANY

Time Petr. Co.

CONTRACTOR

Kirkpatrick

FT. FROM N. LINE


FT. FROM S. LINE

FT. FROM E. LINE

FT. FROM W. LINE

~~NE SW NE~~~~SE NW NE~~SDX - $\frac{1}{2}$ mile

NORTH

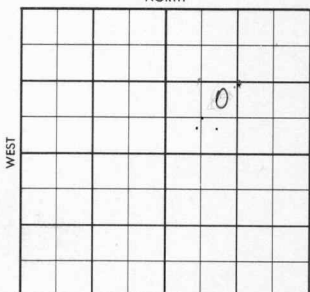

ELEVATION

1956

1635'

REPORT

6-13

Comm. 6-17-56

6-21

MIR

6-28

Spud 6-20-56
8 5/8" @ 172/250
Drlg 2693

7/6

Doug 3505
Lans 3858

7-12

Doug. 3505'; Miss. 4330'
DST 4337-50, op 1 hr, gas to surface
in 50 min, rec. 64' sgcswm, 875/20".
DST 4340-65, op 1 1/2 hr, gas to surface
in 1 hr, 25 min. rec. 50' sgcswm, 1000/
30".

TD 4392,

D & A (holding ticket)

7-19

"

"

7-25

D & A

Dg. 3505'; M. 4330';
TD 4392';

ABANDONED

Elev.

Twp. 30S

Rge. 9W

Company Time Pet. Co.

Farm Name Folkes

No. 2

TOPS	DEPTH	LOG	DATUM	Loc. in Sec.
Anh.				NE SW NE
TP.				
H.				
Tr.				
Dg.				Geol.
BL.				
L.				
K.C.				
B.K.C.				Contr.
Ce.				
C.				
M.				
M.				Kirkpatrick
M.				
K.				
Mz.				
Me.				Pool
V.				
S.				
S.				
A.				SDX - 1/2 mile
R.				
PE.				
G.				
				FIRST REPORT
				JUN 13 '56

Date Comm. 6/17/56

JUN 5 0 1978

R. G.

CORRECTION

FORM 513 SUNRAY

Co.

County KinmanElev. 1635Sec. 32Twp. 30SRgs. 9WCompany Time Pet. Co.Farm Name FalkesNo. 2

	DEPTH	LOG	DATUM
Tr.			
Dg.	<u>3505</u>		
BL.			
L.			
K.C.			
B.K.C.			
Ce.			
C.			
M.	<u>4320</u>		
M.			
K.			
Mz.			
Me.			
V.			
S.			
S.			
A.			
R.			
Pe.			
G.			
T.D.	<u>4392</u>		

Loc. in Sec.

NE SW NESE NW NE

Geol.

Contr.

Kirkpatrick

Pool

ABANDONED

1/2 mile

JUL 25 1956

Lse.

No.

Sec.

T.

R.

Date Comm. 6/17/56 JUN 20 '56 MIR JUN 27 '56C-20-56 85/8 172/2502693 JUL 3 '56 3858 JUL 11 '56DST 4337-50 1hr g to 5.50"TSTM rec 64' 56 C5WM 875120 DST 4340-65 90" g to 51hr 25" TSTM rec 50' 56 C5WM1000/30" JUL 18 '56 JUL 25 '56D&A (Baker)