


Section 32 Township 30 Range 33W

Well No. 1 Gonover

Company Cities Service

NORTH **Hugoton**

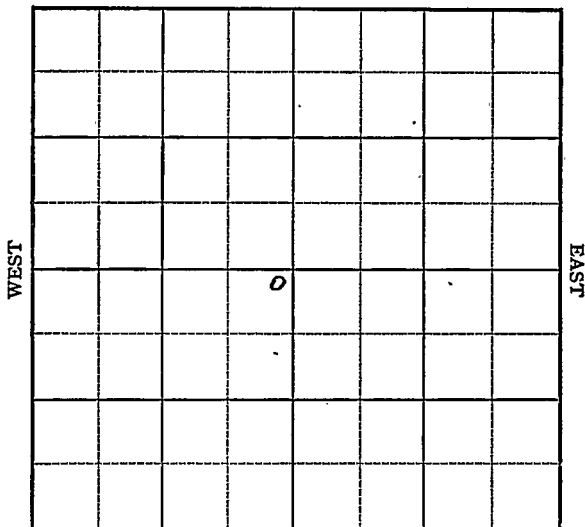

SOUTH

Sec. 32 Twp. 30 R. 33W ✓

Well No. #1 Conover Farm _____

 Cities Service Company

Hugoton Pool (Johnson, Cont.) NORTH


100' Ft. from N. Line

_____ Ft. from S. Line

100' Ft. from E. Line

_____ Ft. from W. Line

NE SW

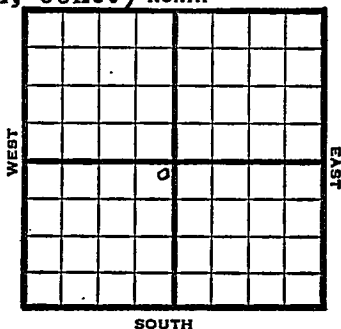

1949

Elev 2952I REPORT

6/1 Location

6/7 8" @ 640'

6/15 TD 2770'
5" @ 2769'

6/21 520 shots 2594-2744 - 27,000 acid

6/28 "

7/6 "

7/13 TD 2770'
5" @ 2769'
Perf 37000 acid
16,300,000 Gas
395# R Pr
omp

COMPLETED

Map No. _____ Sec. 32 Twp. 30 R. 33W

Well No. 1 Conover

Cities Service Company

Johnson Contractor

NE SW

FIRST REPORT
SECTION PLAT

100 Ft. from N. Line

_____ Ft. from S. Line

100 Ft. from E. Line

_____ Ft. from W. Line

	o		

Haskeel County

Location X

Rig up _____

Drilling and Remarks:

RECORD

Cased _____ in., _____ ft.

Sand _____

Gas _____

Oil _____

Total Depth _____

PRODUCTION

1st 24 hrs. Nat. _____

1st 24 hrs. after shot _____

Gas _____ Cu. Ft.

Dry Hole _____

Abandoned _____

Date

JUN 1 1949

S. J. LEWIS Scout

