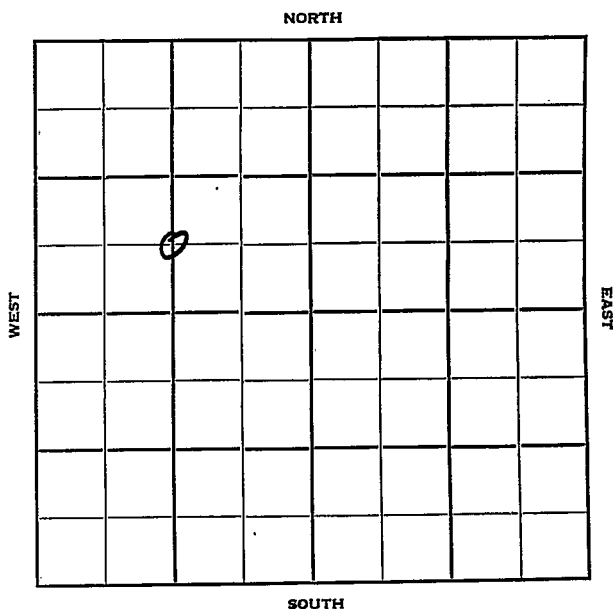


Section 32 Township 30 Range 37WWell No. #2 ComerCompany Hugoton

Sec. 32 Twp. 30 R. 37 W

Well No. # 2 Comer Farm

Hugoton Company

Contractor


2000 Ft. from N. Line

_____ Ft. from S. Line

_____ Ft. from E. Line

1320 Ft. from W. Line

App. C S/2 NW

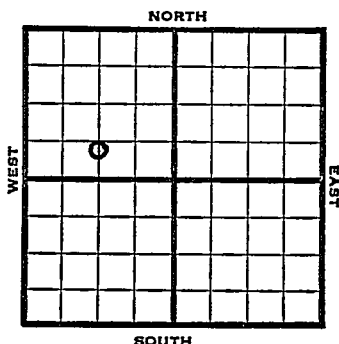


1952	Elev. 3021' REPORT
8/13	RU
8/20	10" @ 440' Drlg. 2195
8/27	NR
9/3	RTD 2377 7" @ 2360
	CO DD 2612 TD
9/10	NR
9/17	Spud 8-13-52
	Gas well TD 2612' 10" @ 440
	TD 2377 7" @ 2360 DD 2612'
	Hol 2322' Her. 2365' Kri. 2382'
	Win. 2457' Ft. Riley 2520'
	16,000 A
	Comp. 20,356,000 gas. 391#
	COMPLETED

County Grant State Kansas
 Sec. 32 (Blk. Twp.) 30 (Sur. Rge.) 57N Map No.

Operator Hugeton

Well No. 2 Farm Cover

Elev. _____ Location App. C S/2 NW

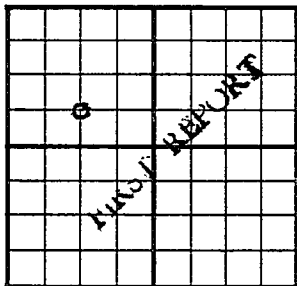

2000 Ft. From N Line NW

1320 Ft. From W Line Quarter

1st. Report AUG 13 1952

Completion _____

Remarks _____

Spudding Date _____

Drlg. Data _____

RU

I. G. McGEHEE

J. G. McGEHEE