


Kiowa

KANSAS

SECTION 33 TOWNSHIP 30S RANGE 16W

WELL NO. #1 Robbins Unit

COMPANY Shell

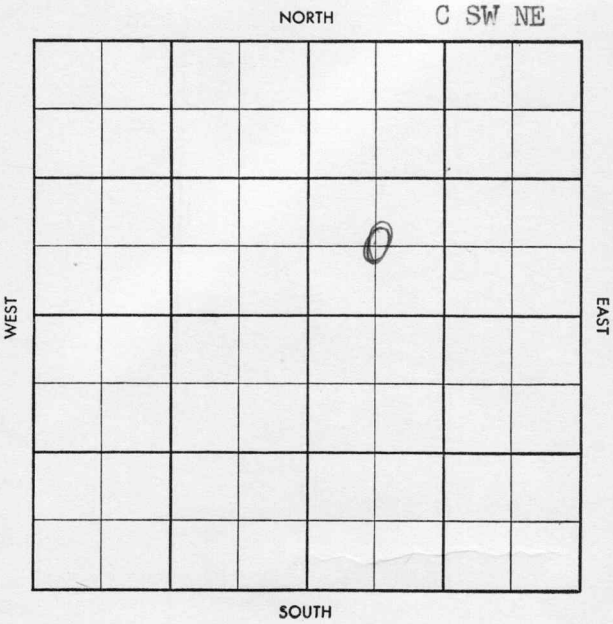



CO. Kiowa ELEV. 1932 DE 4 '57  
SEC. 33 TWP. 30 RGE. 16W  
COMPANY Shell NO. 1 COMPLETE

FARM Robbins Unit

LOC. C SW NE

CO.  
LSE.  
NO.  
SEC.  
TWP.  
RGE.

H 3968
L 4158
M 4717
<del>K 4913</del>

GEOL.  
CONTR. Lewis Drlg.  
POOL Glick  
SPUD 10-11-57  
M I R 97184  
8" 550/500  
12330  
12337 44136  
DST 4714-99  
60" G 1 1/2" ga

7,700 mcf/20" 7,700 mcf  
128" 8,100 mcf/40" 8,300 mcf/60"  
run 10' GCM FP 1675-168  
134P 1750-1735/30"  
run log 4930 NOV 6 '57 P.S.T.  
4908-29 60" 1260' gas 120'  
0 x G C S M FP 30-40 BHP  
177065 - 840/30" T.D 4999  
run log 5" 4850/250

log tops

L 4148 M 4715 K 4870  
W 4905 Hb 3964  
Man 4567 Perf  
NOV 23 '57 PB 4808 212/4715-68  
500A 4 1/2" ga 9,100 mcf  
FTP 275 CR 1100  
51 TP & CP 1525 acid  
pet frac 5D12 hrs FLO  
Ld 7,200 mcf 7 hrs 3 1/4"  
chik FTP 650 & CP 1425  
Sep 8 60" FLO 13,200 mcf  
7 hrs 2" + by FTP 300 Fe  
1425 Sep P 85" 5112 hrs  
51 TP & CP 1550 WOPOT  
NOV 27 '57 Dec 4 '57 CR OPTLO

39,500 mcf  
51P 1543  
Miss