


KANSAS

Grant

Section 33 Township 30 Range 36-W

Well No. #1 Tate

Company United Prod.

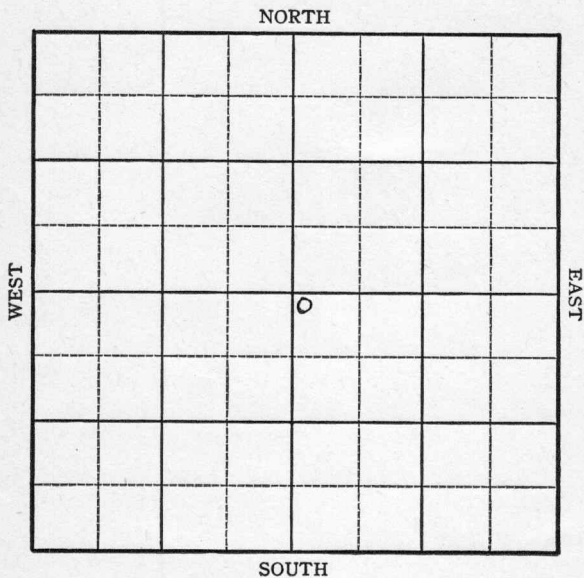

KANSAS

Grant County

Sec. 33 Twp. 30 R. 36W

Well No. #1 Tate Farm _____

United Prod.

Company

Hugoton


100 Ft. from N. Line

Ft. from S. Line

Ft. from E. Line

100 Ft. from W. Line

NW SE

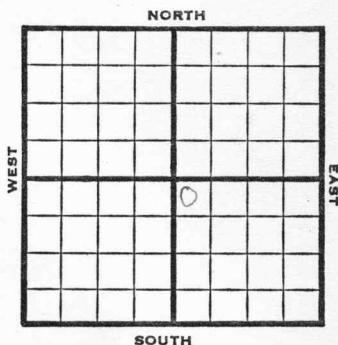

1946

Elev. 3040

REPORT

3/13	RUR		
3/21	"		
3/28	10" - 667'	Drlg.	1771'
4/4	Drlg.	2706	
4/10	TD	2744	
	7" @ 2740	RUST	
4/16	"	"	
4/23	"	"	
5/1	180 shots	2522-2677	
	13000 acid		
5/7	"	"	"
5/14	"	"	"
5/21	"	"	"
5/29	"	"	"
6/5	7" @ 2740		
	TD 2744'		
	Perf.		
	13,000 acid.		
	14,600,000 Gas.		
	387# R Pr.		

COMPLETED

Kansas Pool Name Hugoton**KANSAS**Map No. No map Sec. 33 Twp. 30 R. 36WWell No. 1 TateUnited Prod. CompanyFIRST REPORT Contractor

NW SE

SECTION PLAT

		0	

100 Ft. from N. Line Ft. from S. Line Ft. from E. Line100 Ft. from W. LineGrant CountyLocation Rig up

Drilling and Remarks:

R U R

RECORDCased in., ft.Sand Gas Oil Total Depth **PRODUCTION**1st 24 hrs. Nat. 1st 24 hrs. after shot Gas Cu. Ft.Dry Hole Abandoned

Date

MAR 13 194619S. J. LEWIS Scout

KANSAS


Kansas Pool Name Hugoton PoolMap No. None Sec. 33 Twp. 30 R. 36WWell No. 1 Tate

United Prod. Company

COMPLETED

Contractor

NW SE

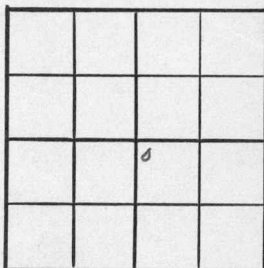E 13040
SECTION PLAT100 Ft. from N. Line

Ft. from S. Line

Ft. from E. Line

100 Ft. from W. Line

Grant County

Location

Rig up

Drilling and Remarks:

7' @ 2740

Prof.

13000 acid

14,600,000 Gas

387 1/2 R.P.

RECORD

Cased _____ in., _____ ft.

Sand _____

Gas _____

Oil _____

Total Depth 2744

PRODUCTION

1st 24 hrs. Nat. _____

1st 24 hrs. after shot _____

Gas _____ Cu. Ft.

Dry Hole _____

Abandoned _____

Date

JUN 5 1946

19

S. J. LEWIS

Scout