


Section 33 Township 30 Range 34W

Well No. 1 C. C. Dennis

Company Trees Oil

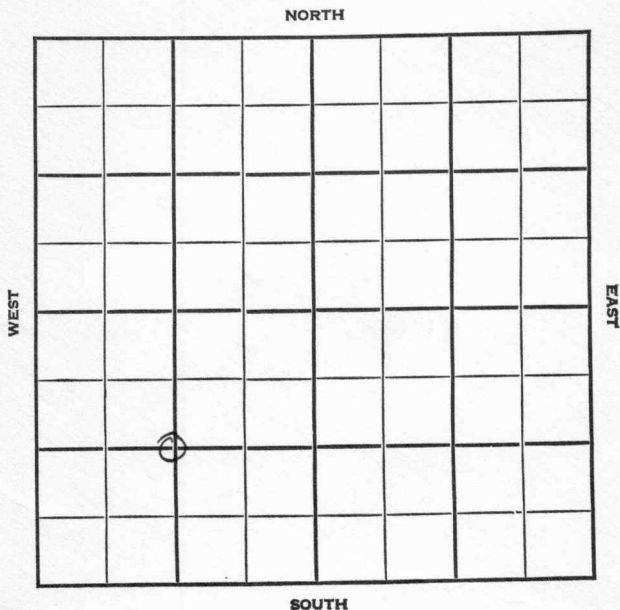

KANSAS

Haskell

Sec. 33 Twp. 30 R. 34W

Well No. #1 C. G. Dennis Farm

Trees Oil
Hugoton

Company


 Ft. from N. Line

1320 Ft. from S. Line

1320 Ft. from E. Line

 Ft. from W. Line

C SW

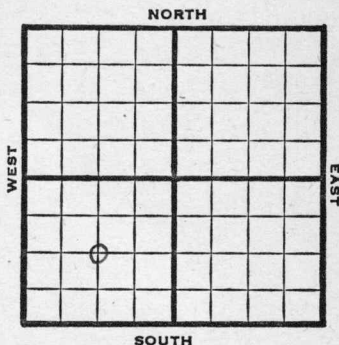

1947

Elev. 2810' REPORT

12/30 Location

1948

1/7

TD 2400'

7" @ 2383'

RUST

1/14

D¹lg 2530'

1/21

TD 2558'

185' of 5" liner @ 2558'

1/26

"

2/4

"

2/11

3000 acid.

2/18

1000 acid

2/25

10,000 acid.

3/3

"

3/10

"

3/17

7" @ 2383'

185' of 5" Perf. liner @ 2558'

Acid 14,000

22,841,000 Gas

R.P. 399#

TD 2558'

COMPLETED

Map No. _____ Sec. 33 Twp. 30 R. 34W

Well No. 1 C. G. Dennis


Trees Oil Company

FIRST REPORT

Contractor

C SW

SECTION PLAT

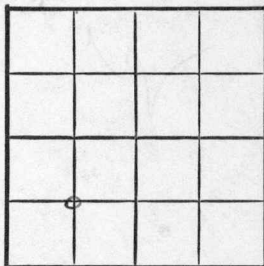

_____ Ft. from N. Line

1320 Ft. from S. Line

1320 Ft. from E. Line

_____ Ft. from W. Line

Haskell County

Location X

Rig up _____

Drilling and Remarks:

RECORD

Cased _____ in., _____ ft.

Sand _____

Gas _____

Oil _____

Total Depth _____

PRODUCTION

1st 24 hrs. Nat. _____

1st 24 hrs. after shot _____

Gas _____ Cu. Ft.

Dry Hole _____

Abandoned _____

Date

DEC 30 1947

19

S. J. LEWIS

Scout

Map No. Sec. 33 Twp. 30 R. 34W

Well No. 1 C. G. Dennis

Trees Oil

 Company


COMPLETE

 Contractor

C SW

E. 2810

SECTION PLAT

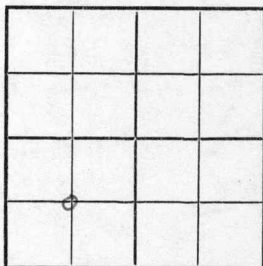

 Ft. from N. Line

1320 Ft. from S. Line

1320 Ft. from E. Line

 Ft. from W. Line

Haskell County

Location

Rig up

Drilling and Remarks:

7" C 2883

185' x 15" Pipe line

C 2885

14000 Rods

22,841,000 Gas

399# RB

RECORD

Cased in., ft.

Sand

Gas

Oil

Total Depth 2885

PRODUCTION

1st 24 hrs. Nat.

1st 24 hrs. after shot

Gas Cu. Ft.

Dry Hole

Abandoned

Date

MAR 17 1948

19

S. J. LEWIS

Scout