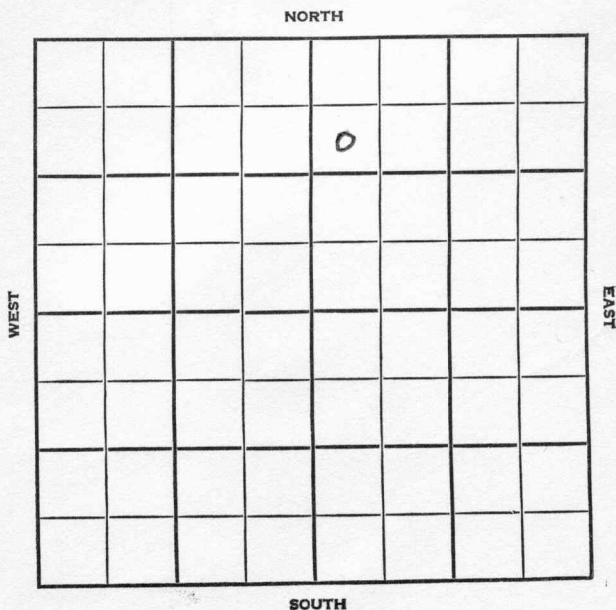


Section 33 Township 30 Range 8 WWell No. #1 Tjaden "F"Company St nolind

Kingman

KANSAS

SEC.	TWP.	R.
33	30	8 W

WELL NO.

1 Tjaden "F"

FARM

COMPANY

Stanolind

CONTRACTOR

Barbour


Spivey

_____ Ft. from N. Line

_____ Ft. from S. Line

_____ Ft. from E. Line

_____ Ft. from W. Line

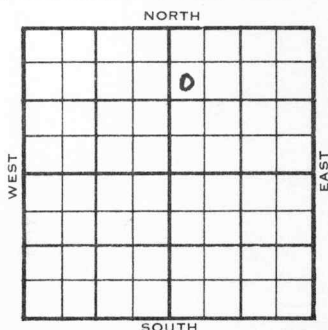

SW NW NE

SDX L_{se} 3/8 Mile

	ELEVATION	REPORT
1956	1591'	
2/29	Location	
3-8	Spud 3-5-56 8 5/8" @ 214/250 Drlg. 1450	
3-15	Lans. 3512, Drlg. 3973'	
3-22	Miss 4290 TD 4480 5 1/2" @ 4479/200 CO 4426	4290 1591 <u>2699</u>
3-29	32/4352-60, S/ ~~X~~ 500 A S/ 1/2 bo 3 1/2 bwph, 24 hrs. CO, 16/ 4351-56, dry, 500 A, S/ 10 bfph, 99% wtr. 20 hrs.	4352 1591 <u>2761</u>
4-5	CO 4436, 20/ 4339-44, S/dry, frac, S/1.7 bo, 1/2 bwph, 24 hrs. frac, failed, 500 A, S/load	
4-12	F/ 3.5 bo, 3.5 bwph, 7 hrs., SI	
4-19	No report	
4-25	Comp. 23 bopd 60% wtr. TD 4480'	

County Kingman Elev. _____ Co.
 Sec. 33 Twp. 30 Rge. 8W
 Company Stanolind
 Farm Name Tjaden "F" No. 1

TOPS	DEPTH	LOG	DATUM	Loc. in Sec.	Lse.
Anh.				SW NW NE	
Tr.					
H.					
Tr.					
Dg.					
BL.					
L.				Geol.	
K.C.				Contr.	
B.K.C.					
Ce.				Barbour	
C.					
M.				Pool	
M.				Spivey	
K.					
Mz.					
Me.					
V.					
S.					
S.					
A.					
R.					
Pe.					
G.					
T.D.					

3/8 mile

FIRST REPORT

FEB 29 '58

Date Comm. _____
 Location _____

27

MAR 5 1956

M. M!

County Kingman Elev. 1591
 Sec. 33 Twp. 30 Rge. 8W
 Company Stanolind
 Farm Name Tjaden "F" No. 1

TOPS	DEPTH	LOG	DATUM	Loc. in Sec.
Anh.				SW NW NE
TP.				
H.				
Tr.				
Dg.				
BL.				
L.	<u>3512</u>		<u>1921</u>	Geol.
K.C.				Contr.
B.K.C.				<u>Barbour</u>
Ce.				Pool
C.	<u>4290</u>		<u>2699</u>	<u>Spivey</u>
M.				
M.				
K.				
Mz.				
Mq.				
V.				
S.				
S.				
A.				
R.				
PE.				
G.				
T.D.	<u>4480</u>			

COMPLETE

Date Comm. 3-5-56 APR 25 1956

8 5/8" @ 214/250 5 1/2" @ 4479/200

CO to 4436 32/ 4352-60 500 A

S/ 1/2 bo 3 1/2 bwph 24 hr. CO

16/ 4351-56 dry 500 A

S/ 10 bfph 99% wtr. 20 hr.

CO to 4436 20/ 4339-44 S/ dry

frac S/ 1.7 bo 1/2 bwph 24 hr. frac

failed 500 A F/ 3.5 bo 3.5 bwph 7 hr.

Comp. 23 bopd 60% wtr.

MAY 4 1956

R. G.