
FORM 51 Kingman KANSAS

Section 33 Township 30 Range 8W

Well No. 1 Tjaden

Company PickrellDrlg.

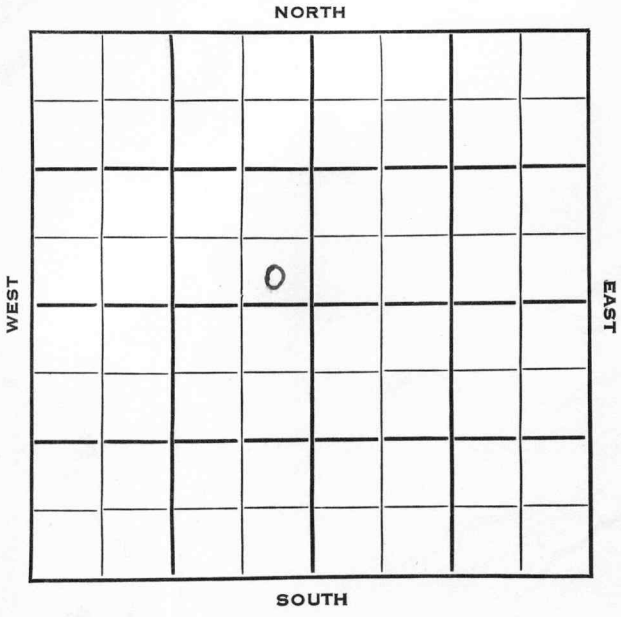

Kingman KANSAS

SEC.	TWP.	R.
33	30	8W

WELL NO.

1 Tjaden FARM


COMPANY

Pickrell Drlg.

CONTRACTOR

Pickrell Drlg.

Banta Pool

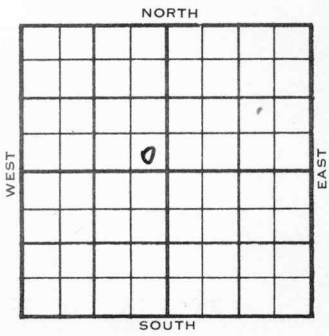

_____ Ft. from N. Line

330 Ft. from S. Line

330 Ft. from E. Line

_____ Ft. from W. Line

SE SE NW

Stanolind - DHM

1954	ELEVATION 1612'	REPORT

1/27 Spud 1-18-54
8" @ 160'
rlg. 3650'

2/3 Lans 3536', Miss 4318',
DST 4385'-4403' 1 hr, 1020' gas, 15' SOCM, 120' Wtr. 1050#
DST 4363'-83' op 1 hr, 3060' gas, 115' oil & gcm 60' wtr, 860#
DST 4327'-58' op 1 hr, 3180' gas, 180' w & gcm 770#
Drlg 4435'

2/10 Spud 1-18-54
D&A
TD 4460'
8" @ 160'
Lans 3536', Miss 4318'
DST 4385-4403', opn 1 hr., rec.1020' gas, 15' socm, 120' wtr, 1050#
DST 4363-83', opn 1 hr., rec. 3060' gas, 115' oil & gcm, 60' wtr., 860#
DST 4327-58', opn 1 hr., rec. 3180' gas, 180' wtr & gcm, 770#
TD 4460'
D&A

4318
1612
2706

ABANDONED

DX-78

FORM 275 FOR SALE BY KANSAS BLUE PRINT CO.

County Kingman State Kansas

Sec. 33 (Blk. Twp.) 30 (Sur. Rge.) 8W Map No.

Operator Pickrell Drlg.

Well No. 1 Farm Tjaden

Elev. Location SE SE NW



330 Ft. From S Line NW

330 Ft. From E Line Quarter

1st. Report JAN 27 1954

Completion

Remarks Stanolind - DHM
pickrell Drlg. - Contr.

Spudding Date 1-18-54

Drlg. Data Banta Pool

8" @ 160 drlg. 3650

J. G. McGEHEE

FORM 275 FOR SALE BY KANSAS BLUE PRINT CO.


County Kingman State Kansas

Sec. 33 (Blk. Twp.) 30 (Sur. Rge.) 8W Map No.

Operator Pickrell Drlg.

Well No. 1 Farm Tjaden

Elev. 1612 Location SE SE NW

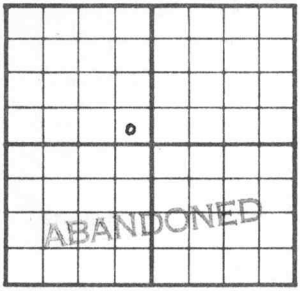

330 Ft. From S Line NW

330 Ft. From E Line Quarter

1st. Report

Completion FEB 10 1954

Remarks Banta Pool

Pickrell Drlg. - Contr.

Spudding Date 1-18-54

Drlg. Data D & A TD 4460

8" @ 160 Lans. 3536 Miss. 4318

DST 4385-4403 open 1 hr. Rec. 1020'

gas 15' socm 120' wtr. 1050#

DST 4363-83 open 1 hr. Rec. 3060' gas

115' oil & gcm 60' wtr. 860#

DST 4327-58 open 1 hr. Rec. 3180' gas

180' wtr & gcm 770# TD 4460

D & A

J. G. McGEHEE