Kingman

KANSAS

SECTION 33 TOWNSHIP 30S RANGE 9W

WELL NO. #1 Twyman

COMPANY Petroleum Inc.

NORTH SE SE SE

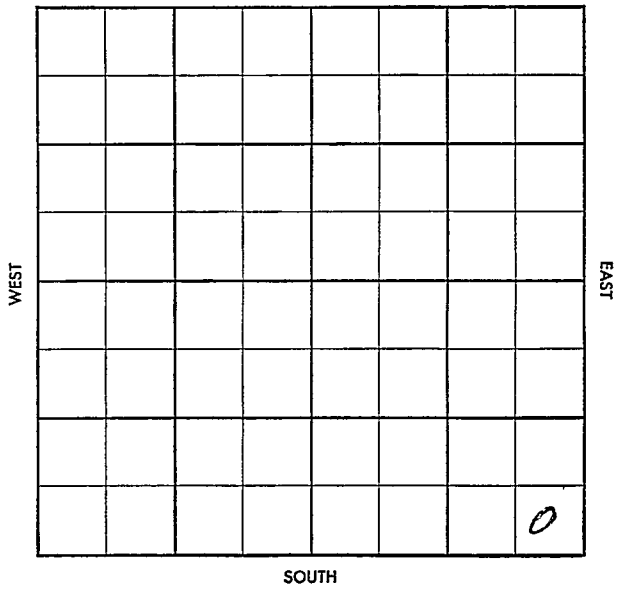

FORM 504-S SUNRAY

Twp. X Pool Rochester

Qu. X Fact. 27

S-513-B

County Kingman Elev.

Sec. 33 Twp. 30 Rge. 9W

Company Petroleum Inc.

Farm Name Twyman No. 1

TOPS	DEPTH	LOG	DATUM
Anh.			
Tp.			
H.			
Tr.			
Dg.			
B.L.			
L.			
K.C.			
B.K.C.			
Ce.			
C.			
M.			
M.			
K.			
Mz.			
Mq.			
V.			
S.			
S.			
A.			
R.			
Pf.			
G.			
T.D.			

Loc. in Sec. SE SE SE

Geol.

Contr. Garvey 5 rig

Pool Spivey-Grabs

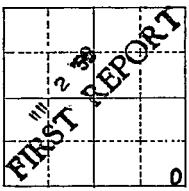

FIRST REPORT 2 30

0

Date Comm. 6-26-58 (Magnolia - FO)

8" @ 279 w/200, Drlg. 2940

Co. Lse. No. Sec. T. R.

Twp X Pool Rochester

Co. X Facet X

S-5[3-B

County Kingman Elev 1710 DF 1713 RB

Sec. 33 Twp. 30 Rge. 9W

Company Petroleum Inc.

Farm Name Twyman No. 1

TOPS	DEPTH	LOG	DATUM
Anh.			
Tp.			
H.	3507		
Tr.	3524		
Dg. 5h	3552		
B.L.			
L.	3714		
KiC.			
B.K.C.			
Ce.			
C.			
M.	4436		
M.			
K.			
Mz.			
Mq.			
V.			
S.			
S.			
A.			
R.			
Pf.			
G.			
T.D.	4536		

Loc. in Sec. SE SE SE

Geol.

Contr. Garvey 5 rig

Pool Spivey-Grabs

ABANDONED

JUL 16 '58

0

Date Comm. 6-26-58 (Magnolia - FO)

8⅝" @ 279 w/200, Drlg. 2340 JUL 9 '58

DST 4437-4536 1hr 35'M FPO

BHP 300/30" mo/log JUL 15 '58

D&A

Co. Lse. No. Sec. T. R.