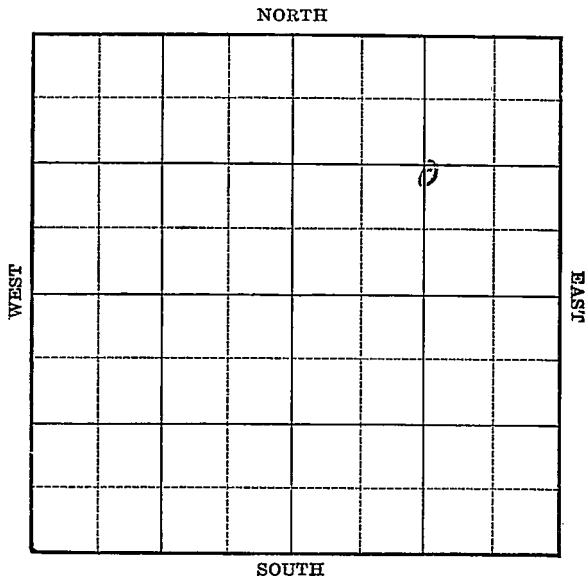


Section 33 Township 30 Range 37WWell No. #1 JoyceCompany Panhandle & Eastern

Map No. 12 Sec. 33 Twp. 30 R. 37WWell No. 1 JoycePanhandle & Eastern Company

Contractor

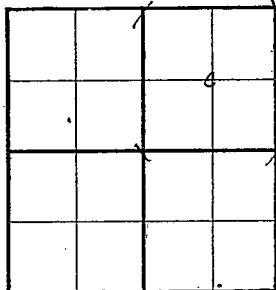
FIRST REPORT

C NE

 Ft. from N. Line1300 Ft. from S. Line1300 Ft. from E. Line Ft. from W. Line

WILDCAT

SECTION PLAT

Location XRig up

Drilling and Remarks:

RECORD

Cased in., ft.Sand Gas Oil Total Depth

PRODUCTION

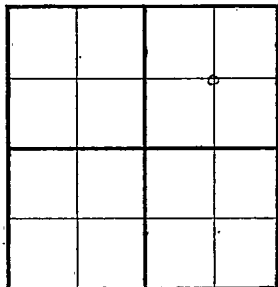
1st 24 hrs. Nat. 1st 24 hrs. after shot Gas Cu. Ft.Dry Hole Abandoned

Date

JUL 1 / 1940 19

S. J. LEWIS

Scout

Map No. 144 Sec. 33 Twp. 30 R. 37WWell No. 1 JoycePanhandle Eastern CompanyContractor**COMPLETED****C NE** Ft. from N. Line1300 Ft. from S. Line1300 Ft. from E. Line Ft. from W. Line**SECTION PLAT****WILDCAT**Location Rig up

Drilling and Remarks:

Herrington 2890
7" @ 2890
10000 acid
22 1/2 M Gas

RECORDCased in., ft.Sand Gas Oil Total Depth 2880**PRODUCTION**1st 24 hrs. Nat. 1st 24 hrs. after shot Gas Cu. Ft.Dry Hole Abandoned

Date

SEP 4 1940 19 S. J. LEWIS Scout