

KANSAS


Barber County

FORM 51 5M 11-44 PETROL

Section 34 Township 30 Range 15W

Well No. #2 Massey "C"

Company Great Lake Carbon

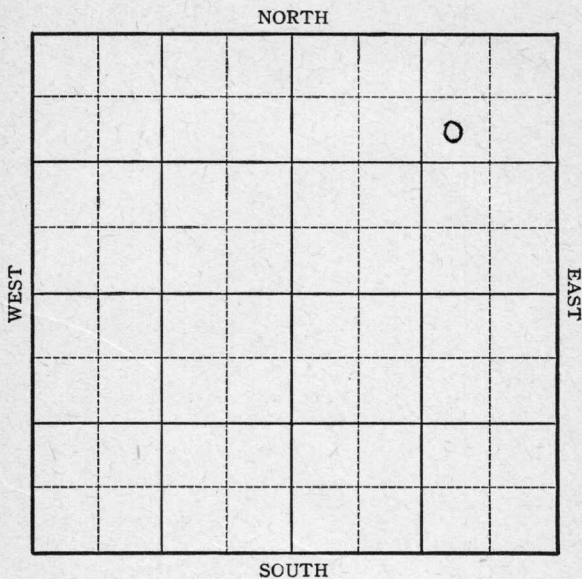

KANSAS

Barber county

Sec. 34 Twp. 30 R. 15W

Well No. #2, Massey "C" Farm

Great Lakes Carbon Company


Sun City

990 Ft. from N. Line

 Ft. from S. Line

990 Ft. from E. Line

 Ft. from W. Line

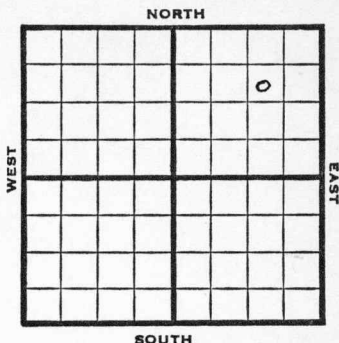

SW NE NE

Elev. 1698

REPORT

1946

6/12

12" @ 80'
635'

6/18

8" @ 639'
Drlg 2590'

6/26

Drlg 4027'

7/3

Lans 3815
Massey 4249
Viola 4413
TD 4451'

ABANDONED

KANSAS

Kansas

Pool Name Sun CityMap No. 92 Sec. 34 Twp. 30 R. 15WWell No. 2 Massey "C"Great Lake Carbon

Company

FIRST REPORT

Contractor

SW NE NE

SECTION PLAT

			0

990 Ft. from N. Line

Ft. from S. Line

990 Ft. from E. Line

Ft. from W. Line

Barber County

Location

Rig up

Drilling and Remarks:

12" @ 80'635'**RECORD**

Cased _____ in., _____ ft.

Sand _____

Gas _____

Oil _____

Total Depth _____

PRODUCTION

1st 24 hrs. Nat. _____

1st 24 hrs. after shot _____

Gas _____ Cu. Ft.

Dry Hole _____

Abandoned _____

Date

JUN 12 1946

19

S. J. LEWIS

Scout

KANSAS

Kansas Pool Name Sun City PoolMap No. 92 Sec. 34 Twp. 30 R. 15WWell No. 2 Massey "C"Great Lakes Carbon Company

ABANDONED

Contractor

SW NE NE

E. 1698

SECTION PLAT

			0

990 Ft. from N. Line Ft. from S. Line990 Ft. from E. Line Ft. from W. LineBarber CountyLocation Rig up

Drilling and Remarks:

Lane 3815Massey 4249Vista 4413

RECORD

Cased in., ft.Sand Gas Oil Total Depth 4451

PRODUCTION

1st 24 hrs. Nat. 1st 24 hrs. after shot Gas Cu. Ft.Dry Hole Abandoned

Date

JUL 3 1946 19S. J. LEWIS