

Barber


KANSAS

SECTION 34 TOWNSHIP 30S RANGE 13W

WELL NO. #1 Hartley "A"

COMPANY Davis Bros. & Honaker-Davis Drlg.

NORTH C SE NE

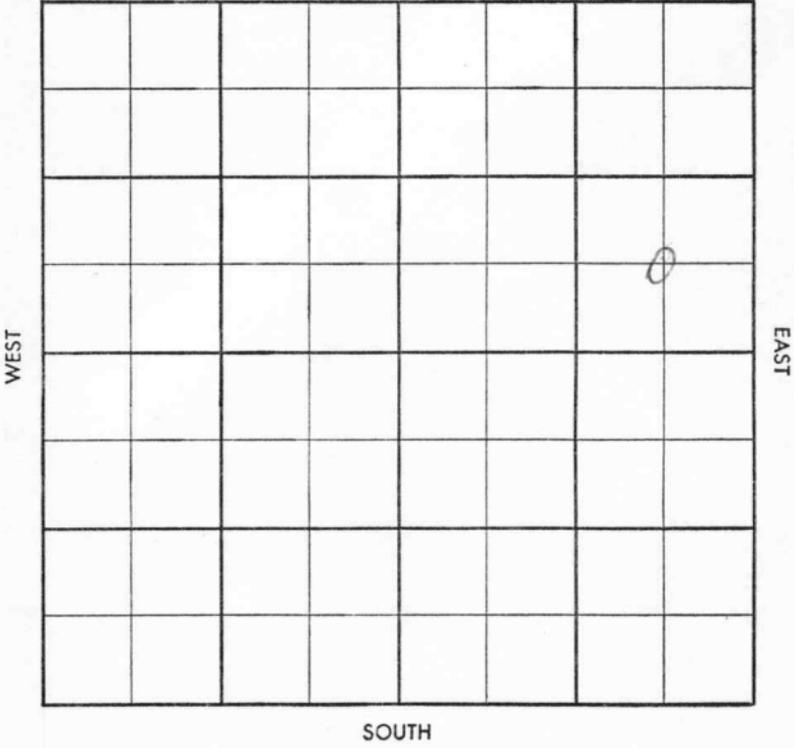

Twp. X Pool X
 Co. X Facet 26

S-513-B

County Barber Elev. _____
 Sec. 34 Twp. 30 Rge. 13W
 Company Davis Bros. & Honaker-Davis Drlg.
 Farm Name Hartley "A" No. 1

TOPS	DEPTH	LOG	DATUM
Anh.			
Tp.			
H.			
Tr.			
Dg.			
B.L.			
L.			
K.C.			
B.K.C.			
Ce.			
C.			
M.			
M.			
K.			
Mz.			
Mq.			
V.			
S.			
S.			
A.			
R.			
Pf.			
G.			
T.D.			

Loc. in Sec. C SE NE
 Geol. _____
 Contr. _____
 Honaker-Davis #4
 Pool _____

JUL 23 1958
 CORE REPORT
 1/8 mile

Date Comm. 4-19-58
8" @ 343 w/275, Drlg. 1081.


Co.
Lse.
No.
Sec.
T.
R.

Twp. _____ Pool _____
 Co. _____ Facet _____

County Warner Elev. _____
 Sec. 34 Twp. 30 Rge. 13W
 Company Davis Bros. & Honaker-Davis Drlg.
 Form Name Hartley "A" No. 18

TOPS	DEPTH	LOG	DATUM
X Anh.	805		
Tp.			
H.	3750		
Tr.			
Dg. Upper	3819		
Lower Dg	3894		
X L.	3931		
K.C.	DST		
B.K.C.			
Ce.			
C.			
X M.	4437		
M.	DST		
K.			
Mz.			
Mq.			
X V.	4570		
S.			
S.			
A.			
R.			
Pf.			
G.			
I.D.	4586		

Loc. in Sec. _____
 C SE NE
 Geol. _____
 Contr. _____
 Honaker-Davis
 Pool W.C. #14

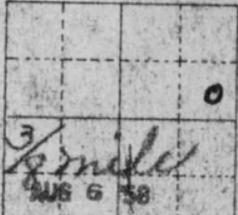

ABANDONED

Date Comm. 4-19-58
 343 w/275, Drlg. 1081. JUL 30 '58 ϕ 3945
 AUG 6 58 Tops DST 3780 - 3915 op 30" g/lz"
 ga 1.450 mcf rec 750' gray w (too much water)
 BHP 1463/30" DST 4369 - 95 op 60"
 200' gip rec 102' H gem / tv oil BHP
 502/30" top DST 4440 - 60 op 1hr 22'
 M FBHP 81/30" Top Log 2

DobA

Co.
 Lse
 No.
 Sec.
 T.
 R.