

KANSAS

Grant

Section 34 Township 30 Range 35W

Well No. 1 Kuhn "A"


Company Magnolia

Hugoton

NORTH

WEST

EAST

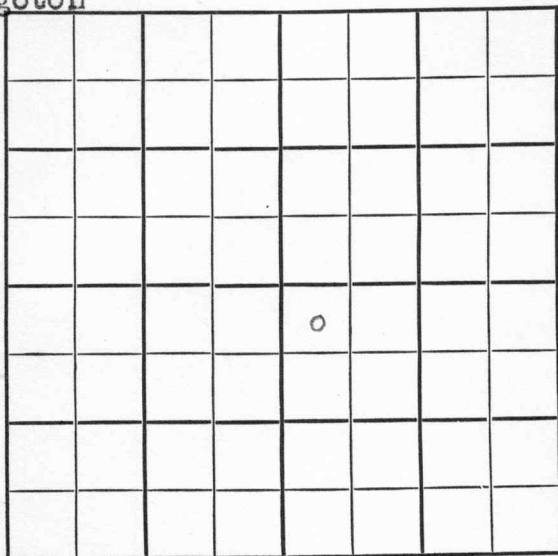

SOUTH

KANSAS 30

Grant

34

35W

Sec. _____ Twp. _____ R. _____

Well No. #1 Kuhn "A" Farm _____

Magnolia

Company _____

Hugoton

330


Ft. from N. Line

Ft. from S. Line

Ft. from E. Line

330

Ft. from W. Line

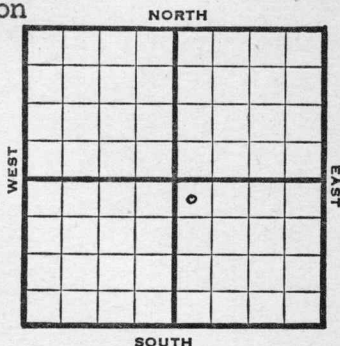

NW SE

1947

Elev. 2863 REPORT

10/22

Location

10/29

10" @ 760'

Drlg. 2060'

11/5

7" @ 2680'

TD 2709'

11/12

192 shots ~~2548~~-88' - 7000 acid.

96 shots 2496-2518 - 7000 acid.

11/25

7" @ 2680

Perf. 21000 acid

15,500,000 Gas

TD 2709

405# R Pr.

COMPLETED

Kansas Hugoton

Map No. _____ Sec. 34 Twp. 30 R. 35WWell No. 1 Kuhn "A"Magnolia Company

FIRST REPORT Contractor


NW SE

SECTION PLAT

330 Ft. from N. Line

_____ Ft. from S. Line

_____ Ft. from E. Line

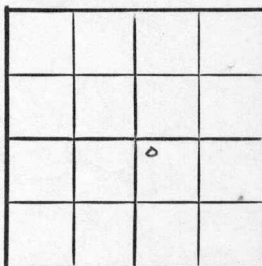330 Ft. from W. Line

Grant County

Location X

Rig up _____

Drilling and Remarks:

RECORD

Cased _____ in., _____ ft.

Sand _____

Gas _____

Oil _____

Total Depth _____

PRODUCTION

1st 24 hrs. Nat. _____

1st 24 hrs. after shot _____

Gas _____ Cu. Ft.

Dry Hole _____

Abandoned _____

Date

OCT 22 1947 19S. J. LEWIS Scout

Map No. Sec. 34 Twp. 30 R. 35W

Well No. 1 Kuhn "A"

Magnolia Company

COMPLETE

Contractor

NW SE


E 1.2863
SECTION PLAT

330 Ft. from N. Line

 Ft. from S. Line

 Ft. from E. Line

330 Ft. from W. Line

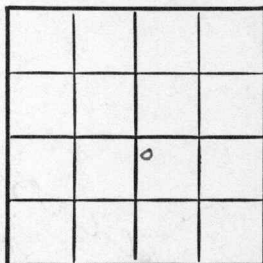

Grant County

Location

Rig up

Drilling and Remarks:

7" 02680
Perf.
21500 and
15,500,000 Gas
405 # R/E

RECORD

Cased in., ft.

Sand

Gas

Oil

Total Depth 2708

PRODUCTION

1st 24 hrs. Nat.

1st 24 hrs. after shot

Gas Cu. Ft.

Dry Hole

Abandoned

Date

NOV 25 1947

19

S. J. LEWIS

Scout