

Kingman

KANSAS

SECTION 34 TOWNSHIP 30 RANGE 8W

WELL NO. #1 Banta

COMPANY Mull Drlg.

NORTH

WEST

EAST

SOUTH

0

SEC.	TWP.	R.
34	30	8W

WELL NO.

#1 Banta

FARM

COMPANY

Mull Drlg.

CONTRACTOR

Co . Tools


_____ Ft. from N. Line

_____ Ft. from S. Line

_____ Ft. from E. Line

_____ Ft. from W. Line

SW SW SE

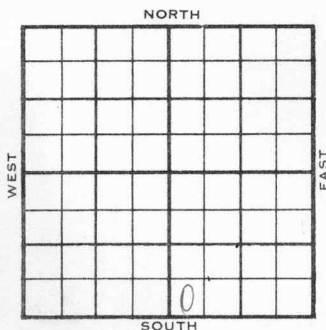

Magnolia - FO

1956	ELEVATION	REPORT
	1647	
5-16		Conn. 5-12-56 8" @ 160 w/125 Drlg. 2710
6-27-		DST 4360-70 2 hrs g in 4" ga 190 MCFG rec 60' G & OCM / 70 Mdy oil / 5' MW, BHP 1310 DST 4370-75 2 hrs g in 6" ga 129 MCF rec 100' GCM / 100' oily MD / 10' wtr, BHP 1315 5 1/2" @ 4378/115 CO 4376 1/2 60/4365-75 Frac. F/W 13 BPL 2% wtr. Flo 4 BOPH / 5% with 15 hrs 1/64" Aise Flw 60 BOPD 11/64" ch / 1 mill. CFG Ph Flw 109 BO / 8% wtr. M. 4359 TD. 4378
		COMPLETED
		4365 1647 <hr/> 2718

County Kinman Elev. _____
 Sec. 34 Twp. 30 Rgs. SW
 Company Mull Drlg.
 Farm Name Banta No. 1

TOPS	DEPTH	LOG	DATUM	Loc. in Sec.
Anh.				SW SW SE
TP.				
H.				
Tr.				
Dg.				
Bl.				
L.				Geol. _____
K.C.				Contr. _____
B.K.C.				Co. tools Pool <u>SPINEY</u>
Ce.				
C.				
M.				
M.				
K.				
Mz.				
Ma.				
V.				
S.				
S.				
A.				
R.				
PE.				
G.				
T.D.				

FIRST REPORT
 MAY 16 56

Date Comm. 5-12-56 Magnolia - FO
8" @ 160/125 drlg. 2710

MAY 16 1956
 R.G.R.

27

Co.
 No.
 Sec.
 T.
 R.

County Kinman Elev. 1647
 Sec. 34 Twp. 30 Rgs. 8W
 Company Mull Drlg.
 Farm Name Banta No. 1

TOPS	DEPTH	LOG	DATUM	Loc. in Sec.
Anh.				SW SW SE
Tr.				
Dg.				
Bl.				
L.				Geol.
K.C.				Contr.
B.K.C.				Co. tools
Ce.				Pool SPIVEY
C.				
M.	4359		2712	
M.				
K.				
Mz.				
Mo.				
V.				
S.				
S.				COMPLETE
A.				
R.				
Pe.				
G.				
T.D.	4378			

Date Comm. 5-12-56 Marnolia - FO
8" @ 160/125 - drlg. 2710 MAY 23 '56

DST 4360-70 2 hrs 9 in 4"
9a 190 MCFG rec 60' G & 6 CM
+ 70 Mdy oil + 5' MW BHP 1310
DST 4370-75 2 hrs 9 in 6"
9a 129 MCF rec 100' 6 CM +
100' oily Md + 10' wtr BHP 1315
5 1/2 @ 4378/115 MAY 29 '56 CO 4376 1/2
60/4365-75 Frac Flw 13 BOPH

34-30-80

SW SW 23

2% wtr. JUN 6 '56 Flg 4 BOPH + 5%

wtr 15 hrs "1/64" ch

+ Est 1 MCFG. Univ JUN 20 '56 F/W

60 Bopd "1/64" ch + 1 Mill.

CFG. JUN 27 '56 Ph F/W 109 B0

+ 8% wtr.