


Section 34 Township 30 Range 8W

Well No. 1 Boyle "B"

Company Pickrell Drig.

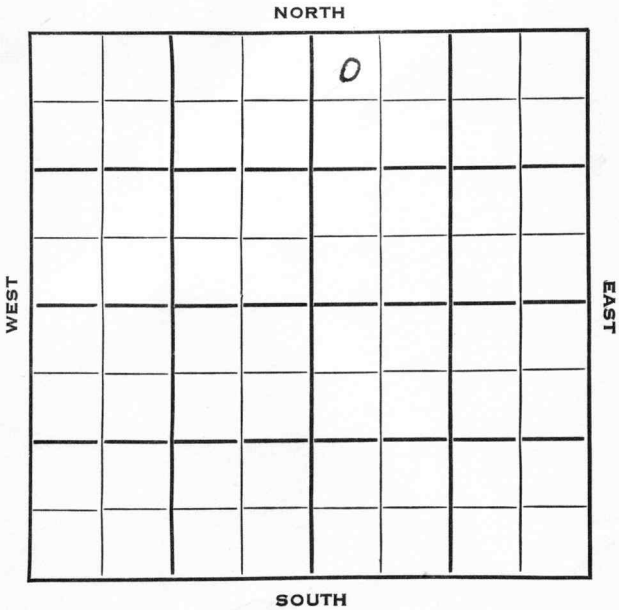

Kingman

KANSAS

SEC.	TWP.	R.
34	30	8 W

WELL NO.

1 Boyle "B"

FARM

COMPANY

Pickrell Drlg.

CONTRACTOR

Pickrell Drlg.

Wildcat

330

Ft. from N. Line


Ft. from S. Line

Ft. from E. Line

330

Ft. from W. Line

NW NW NE

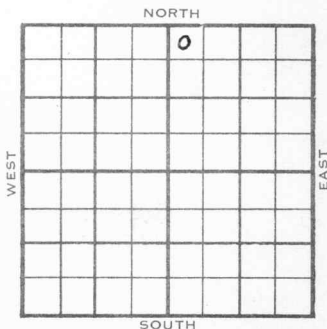

1953	ELEVATION	REPORT
	1589'	

12/16

Location

1954

3/31

Spud 12-11-53 D & A

TD 4397 8" @ 196 Lans. 3485

Miss 4288

DST 4291-4305 open 1 hr rec 90'

HO & GCM, 120' GC & SMC0 1200#

TD 4305 5" @ 4304 DD 4312

sd-oil-frac. F/51 BO 1 hr.

F/18 BO 3rd hr. F/20 BOPH 2 hr.

DD 4339 sd-oil-frac. S/8 BFPH

80% wtr. sd-oil-frac.

DD 4397' ~~D & A~~

Shut IN Gas Well - IMCFGPD

(see CORR. Ticket 5-26-54)

~~ABANDONED~~

COMPLETED

4291

1589

702

County Kingman State Kansas
 Sec. 34 (Blk.) 30 (Sur.) 8W Map No.
 Operator Pickrell Drlg.
 Well No. 1 Farm Boyle "B"
 Elev. _____ Location NW NW NE

330 Ft. From N Line NE
330 Ft. From W Line Quarter

1st. Report DEC 16 1953

Completion _____

Remarks _____

Pickrell Drlg. - Contr.

Spudding Date _____


Wildcat

Drlg. Data _____

Location

J. G. McGEHEE

County Kingman State Kansas
 Sec. 34 (Blk. 30 (Sur. 8W Map No.
 Twp.) Rge.)
 Operator Pickrell Drlg.
 Well No. 1 Farm Boyle "B"
 Elev. 1589 Location NW NW NE

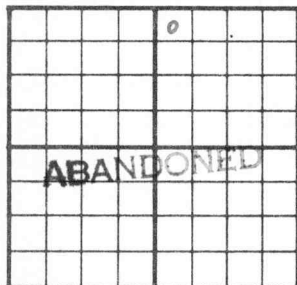

330 Ft. From N Line NE
330 Ft. From W Line Quarter
 1st. Report
 Completion MAR 31 1954
 Remarks Wildcat
Pickrell Drlg. - Contr.
 Spudding Date 12-11-53

Drlg. Data D & A TD 4397
8" @ 196 Lans. 3485 Miss. 4288
DST 4291-4305 open 1 hr. Rec. 90' ho &
gcm 120' gc & smco 1200# TD 4305
5" @ 4304 DD 4312 sd-oil-frac
F/ 51 bo 1 hr. F/ 18 bo 3rd hr.
F/ 20 boph 2 hr. DD 4339 sd-okl-frac
S/ 8 bfph 80% wtr. sd-oil-frac
DD 4397

D & A

J. G. McGEHEE

Kansas

Map No. _____ Sec. 34 Twp. 30 R. 8W

Well No. 1 Boyle "B"

Pickrell Drlg.

Company

CORRECTION

Contractor

NW NW NE

SECTION PLAT

		0	

330 Ft. from N. Line

_____ Ft. from S. Line

_____ Ft. from E. Line

330 Ft. from W. Line

Kingman County

Location _____

Rig up _____

Drilling and Remarks:

Comp. 3-31-54

D & A

Should be shut in
gas well
1 mcfgpd

RECORD

Cased _____ in., _____ ft.

Sand _____

Gas _____

Oil _____

Total Depth _____

PRODUCTION

1st 24 hrs. Nat. _____

1st 24 hrs. after shot _____

Gas _____ Cu. Ft.

Dry Hole _____

Abandoned _____

Date

MAY 26 1954

19

J. G. MCGEE

Scout