


Section 34 Township 30 Range 9 W

Well No. # 1 Keimig

Company Pickrell Drlg.

NORTH

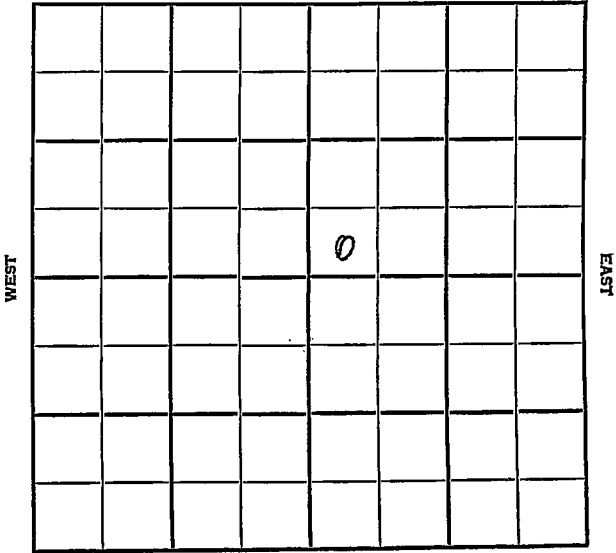

SOUTH

Kingman

KANSAS

SEC.	TWP.	R.
34	30	9W

WELL NO. #1 Keimig FARM

COMPANY Pickrell Drlg.

CONTRACTOR Co. Tools.


Wildcat.

Ft. from N. Line

330 Ft. from S. Line

Ft. from E. Line

330 Ft. from W. Line

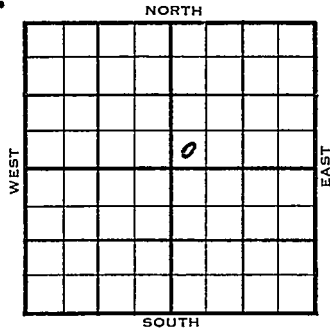

SW SW NE

1955	ELEVATION	REPORT
------	-----------	--------

3/16 Spud 3-14-55
8-5/8" @ 120'
WOC

County Kingman State KansasSec. 34 (Blk. Twp.) 30 (Sur. Rge.) 9W Map No.Operator Pickrell Drlg.Well No. 1 Farm KeimigElev. Location SW SW NE330Ft. From S Line NE330Ft. From W Line Quarter1st. Report MAR 1.6 1955

Completion

Remarks

Co. toolsSpudding Date 3-14-55Drlg. Data Wildcat8 5/8" @ 120 WOC

FABEN GILSTRAP