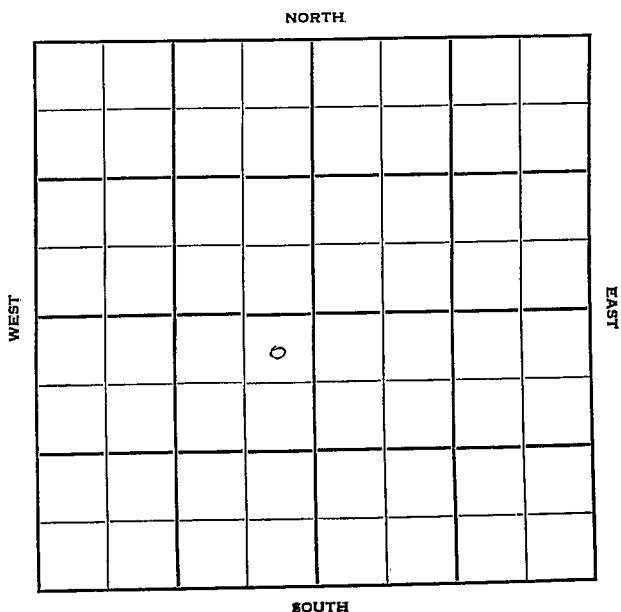


Section 34 Township 30 Range 33WWell No. #1 E. HopkinsCompany Magnolia

KANSAS

Haskell

Sec. 34 Twp. 30 R. 33-W ✓

Well No. #1 E. Hopkins Farm

Magnolia Company

Barnett Drlg. Contractor

Hugoton


330 Ft. from N. Line

 Ft. from S. Line

330 Ft. from E. Line

 Ft. from W. Line

NE NE SW

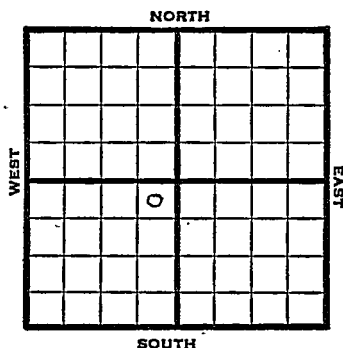

1950

Elev 2931 REPORT

10/4

Cellar & pits

11/8

Spud 10-5-50

10" @ 693

6" @ 2784

TD 2795

Towanda 2751

96/2700-18, 120/2653-80, 96/2626-44

48/2599-2608

27000 A

Comp 17,200,000 gas

TD 2795

Completed

COMPLETED

J. E. TYRA

Sec. 34 (Blk. Twp.) 30 (Sur. Rge.) 3 3W Map No.

Well No. 1 Farm E. Hopkins

Elev. 2931 Location NE NE SW

COMPLETE

0

330 Ft. From N Line SW

330 Ft. From E Line Quarter

1st. Report

Completion NOV 8 1950

Remarks Hugoton Pool

Barnett Drlg. - Contr.

Spudding Date 10-5-50

Drlg. Data Gas well TD 2795

10" @ 693 6" @ 2784 TD 2795

Towanda 2751 96/ 2700-18 120/ 2653-80

96/ 2626-44 48/ 2599-2608 28000 A

Comp. 17,200,000 gas

J. E. TYRA