


Section 34 Township 30 Range 1W

Well No. 1 Nixon

Company Morris Mizel

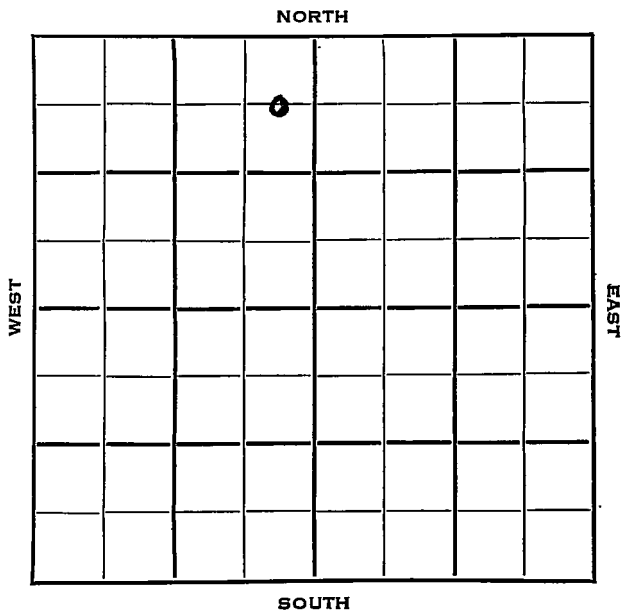

SEC. 34	TWP. 30	R. 1W
------------	------------	----------

WELL NO. #1 Nixon FARM

COMPANY Morris Mizel

CONTRACTOR H J. Uhl

Wildcat.


660 Ft. from N. Line

Ft. from S. Line

330 Ft. from E. Line

Ft. from W. Line

C E L N E N W

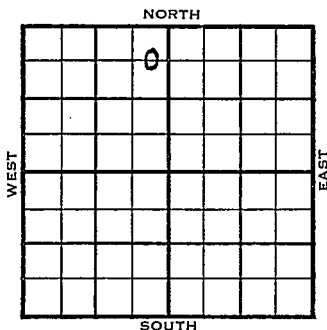

1953	ELEVATION	REPORT
------	-----------	--------

12/30	Spud 12-11-53 10" @ 334' Miss 3575' Drlg 3681'
1954 1/6	D & A
1/20	Spud 12-11-53 D&A TD 4064' 10" @ 334' Miss 3575', Stal. 2625', KC 2940', Kh. 3912', Simp. 3960' DST 3908-69', opn 1 hr., rec. 160' mud, & wtr., 780# DST 3984-93', opn 1 hr., rec. 15' mud, 640# Arb. 4055' TD 4064' D&A

ABANDONED

