

1954

7/29

Completed for 4,300,000 CFGPD

(Ltr-McGehee)

7/28

Spud 6-7-54 - Gas Well

TD 5554'

8" @ 1525'

Anhy 1514', Top 2960'

DST 3000-98', opn 2 hrs., rec. 253'

sul. wtr, 420#

Lans 3475'

DST 3490-3508', opn 1 hr., rec. 675'

sw,

DST 3709-18', opn 1 hr., rec. 1400'

sw, 690#

B KC 3870', Marm. 4135', Morrow 4928',

Keys sd 5180'

DST 5180-5211', opn 1½ hrs., rec. 60'

mud, 1015#

DST 5211-5273', opn 2 hrs., rec. 4¼

MCFG, 375' g & dist. cm, 1275#

DST 5273-5324', opn 1 hr., 100,000 gas

2280' vhg & dist csw, 1300#

DST 5345-54', opn 1 hr., rec. 7' mud,
0#

Chester 5354', St. Gen. 5390'

TD 5554'

5" @ 5375'

4/5284-85, 5,000,000 gas,

10 bswph 4/5274-75, 6/5273-75, 20/

5268-73, 100,000 cfg, 40/5258-68,

250,000 cfg, 16/5254-58, 300,000 gas

640,000 cfg, 1 hr., 1,250,000 cfg 5 hr

1/3 bwph 1500A

Dol-frac, 16,500,000 gas, 6 hrs.

Comp. 4,300,000 cfgpd

COMPLETED

County Stanton State KansasSec. 34 (Blk.) 30 (Sur.) 42W Map No.Operator Huber OilWell No. 1 Farm SparksElev. 3508 Location C NE/41320 Ft. From N Line NE1320 Ft. From E Line Quarter1st. Report JUN 9 1954Completion near MCPC acreageRemarks Miss. testHuber - Contr.Spudding Date 6-7-54Drig. Data Carter, Skelly & Superior IHM
Superior AC
drig. 710

14-1471 DE
1 mile
7/10/54


✓

Scout Cards	MMM
Land Small Map	
Land Wall Map	
Tracings	
France Map	
Pleasant Map	
Misc.	

JUN 11 1954

Orig. Data

County Stanton State Kansas
 Sec. 34 (Blk. Twp.) 30 (Sur. Rge.) 42W Map No.
 Operator Huber Oil
 Well No. 1 Farm Sparks
 Elev. 3508 Location C NE/4

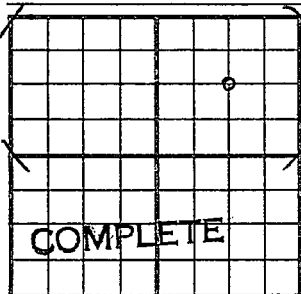

1320 Ft. From N Line NE
1320 Ft. From E Line Quarter
 Ist. Report
 Completion JUL 28 1954
 Remarks
Huber - Contr.
 Spudding Date 6-7-54

Drlg. Data Gas well TD 5554
8" @ 1525 Anhy 1514 Top. 2960
DST 3000-98 open 2 hr. Rec. 253' sul.
wtr. 420# Lans. 3475 DST 3490-3508
open 1 hr. Rec. 675' sw DST 3709-18
open 1 hr. Rec. 1400' sw 690#
B KC 3870 Marm. 4135 Morrow 4928
Keys sd 5180 DST 5180-5211 open 1½ hr.
Rec. 60' mud 1015# DST 5211-5273
open 2 hr. Rec. 4¼ mcfg 375' g & dist.
cm 1275# DST 5273-5324 open 1 hr.
100,000 gas 2280' vhg & dist csw 1300#
DST 5345-54 open 1 hr. Rec. 7' mud 0#
Chester 5354 St. Gen. 5390 TD 5554
5" @ 5375 4/ 5284-85 5,000,000 gas

J. G. McGEHEE

AUG 4 1952

10 bswph	4/ 5274-75	6/ 5273-75
20/ 5268-73	100,000 cte	40/ 5258-68
250,000 cte	16/ 5254-58	300,000 cte
640,000 cte	1 hr.	1,250,000 cte
1/3 bwpb	1500 A	461-1 trac
16,500,000 cte	6 hr.	Land Wall Map
Comp. 4,300,000	dd	Scout Cards

Drig. Data