


Well No. 3 Massey "A"

Company Great Lake Carbon

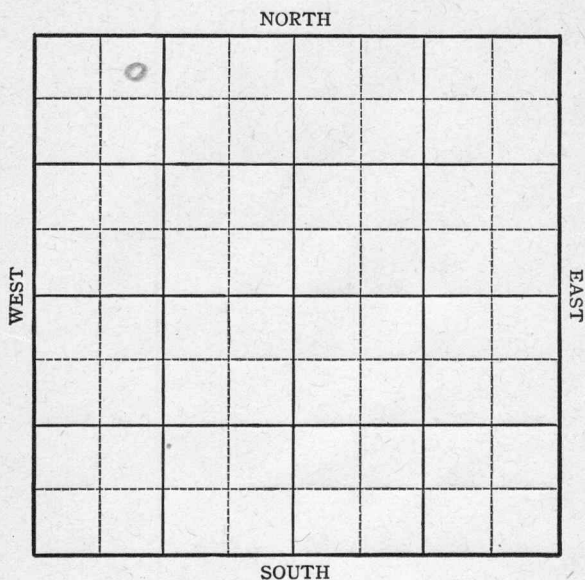

KANSAS Barber

Sec. 35 Twp. 30 R. 15-W

Well No. #3 Massey "A" Farm


Great Lake Carbon Company

330 Ft. from N. Line

 Ft. from S. Line

 Ft. from E. Line

990 Ft. from W. Line

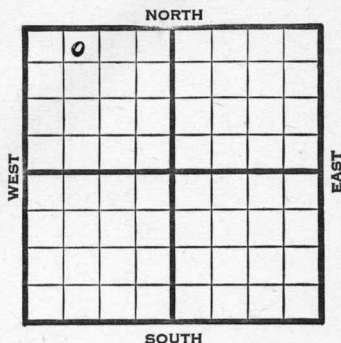

NE NW NW Elev. 1781

1945

REPORT

7/18

RUR

7/26

Anhy 620

8" @ 660

Drlg. 1875'

8/1

3081 crooked hole PB

8/8

PB 2000

8/15

Drlg. 2085

8/22

Drlg. 2955

8/29

Lans 3902

Drlg. 4150

9/5

Massey zone 4337-4347

TD 4347

5" @ 4336 RUST

9/12

3550' oil in 8 hrs. SD

9/19

500 acid.

Pump 130 oil in 13 hrs.

9/26

" " " "

10/3

" " " "

10/10

Pump 35 oil per hr. 8 hrs.

10/17

Massey zone 4337

5" @ 4336

500 acid.

TD 4337

Pump 612 Pot.

Grav. 39.0

COMPLETED

KANSASKansas Pool Name Sun CityMap No. 92 Sec. 35 Twp. 30 R. 15WWell No. 3 Massey "A"Great Lake Carbon Company**FIRST REPORT**

Contractor

NE NW NW

SECTION PLAT

0			

330 Ft. from N. Line Ft. from S. Line Ft. from E. Line990 Ft. from W. Line

Barber County

Location Rig up

Drilling and Remarks:

RUR

RECORDCased in., ft.Sand Gas Oil Total Depth **PRODUCTION**1st 24 hrs. Nat. 1st 24 hrs. after shot Gas Cu. Ft.Dry Hole Abandoned

Date

JUL 1 8 1945 19S. J. LEWIS Scout

KANSAS

Kansas

Pool Name Sun CityMap No. 92 Sec. 35 Twp. 30 R. 15WWell No. 3 Massey "A"Great Lakes Carbon

Company

COMPLETED

Contractor

E. J. 1787

NE NW NW

SECTION PLAT

330 Ft. from N. Line Ft. from S. Line Ft. from E. Line990 Ft. from W. Line

Barber County

0			

Location Rig up

Drilling and Remarks:

Massey zone 433?5" @ 433 1/2500 acidPring 612 Pk39-0-44**RECORD**Cased in., ft.Sand Gas Oil Total Depth 433?**PRODUCTION**1st 24 hrs. Nat. 1st 24 hrs. after shot Gas Cu. Ft.Dry Hole Abandoned

Date

OCT 17 1945

19

S. J. LEWIS

Scout