


Section 35 Township 30 Range 15-W

Well No. #1 Massey

Company Pryor & Lockhart et al

Wildcat

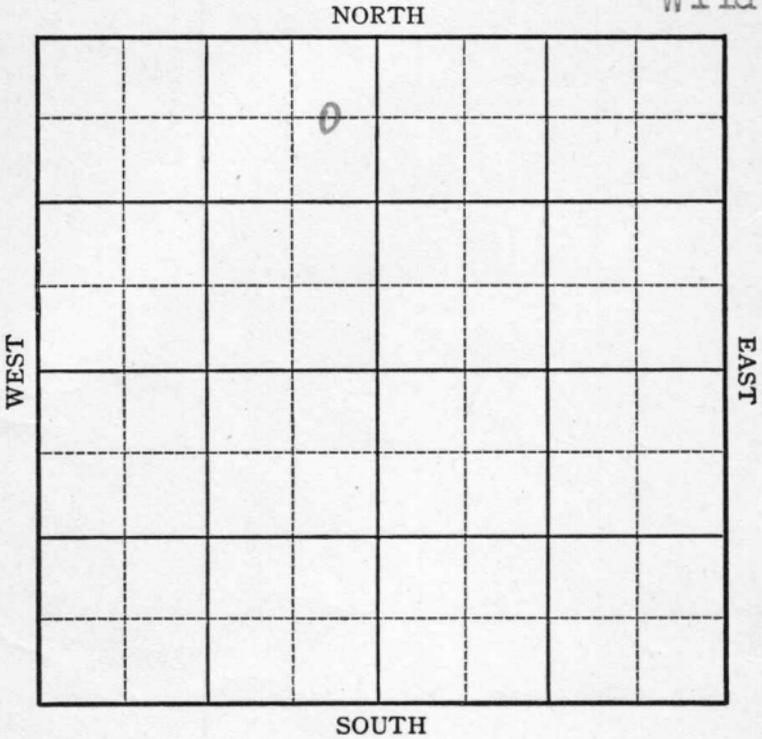

Sec. 35 Twp. 30 R. 15 -W

Well No. #1 Massey Farm

Pryor & Lockhart et al Company

(Wild cat)


660 Ft. from N. Line

_____ Ft. from S. Line

330 Ft. from E. Line

_____ Ft. from W. Line

Elev. 1787

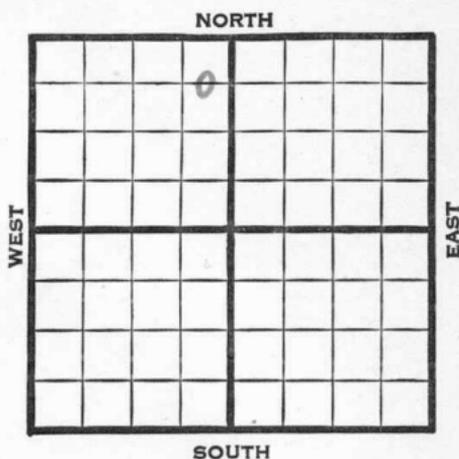

1941	REPORT
10/15	Derrick.
10/23	"
10/30	12" - 152' T.D. 963' WOC.
11/6	Drlg. 2500'
11/13	Lans. 3907' Drlg. 4084'
11/20	Viola 4508 ⁴⁵⁰¹ ' Drlg. 4560'
11/28	Viola 4501' (Corrected)
	Simp. 4596' Arb. 4676'
	T.D. 4726' P.B.
12/3	T.D. 4726 in Arbuckle Lans. 3907
	Had show oil in Lansing 4346-57
	Set 5 $\frac{1}{2}$ " 4448
	Shot 1 shot 4342--no show
	Shot 1 shot 4343 small show gas
	Shot 1 shot 4344--hole full oil 1/4
	hour Started to flow Flowing over
	top derrick Estimate 30 bbls. oil per
	hour No control head Flowing wild
	No water Grav. around 38 or better
	No estimate gas (Tel)
	OVER

1941

12/11 12 shots 4343-44'
12 " 4342-43'

Flow 125 oil per hour for 2 hours.
Shut down.

12/18 " " " " "

12/23 Lans. 3907'
7" - 4448'
T.D. 4719'

3 shots 4342-44'
24 " 4342-44'
Bomb potential 6112 bbls.
Maximum 3000 bbls.
33. Gravity

COMPLETED

Map No. K. 92 Sec. 35 Twp. 30 R. 15W

Well No. 1 Massey

Pryor & Lockhart et al Company

FIRST REPORT

Contractor

C E L N E N W


660 Ft. from N. Line

_____ Ft. from S. Line

330 Ft. from E. Line

_____ Ft. from W. Line

SECTION PLAT

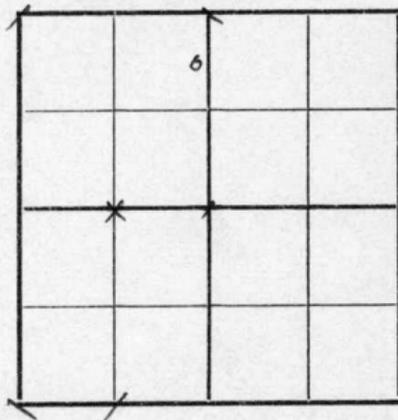

WILDCAT

Location _____

Rig up _____

Drilling and Remarks:

Derrick

RECORD

Cased _____ in., _____ ft.

Sand _____

Gas _____

Oil _____

Total Depth _____

PRODUCTION

1st 24 hrs. Nat. _____

1st 24 hrs. after shot _____

Gas _____ Cu. Ft.

Dry Hole _____

Abandoned _____

Date

OCT 15 1941


19

S. J. LEWIS

Scout

Map No. _____
 Sec. _____ Twp. _____ R. _____
 Well No. _____
 Location _____
 Contractor _____

SECTION PLAT

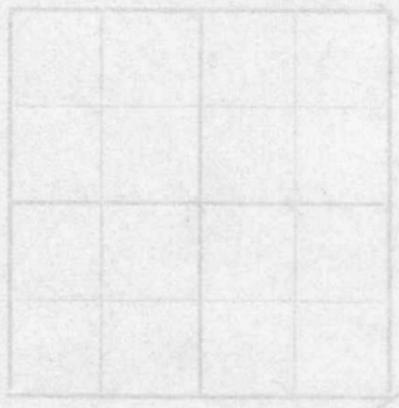

_____ Ft. from N. Line
 _____ Ft. from S. Line
 _____ Ft. from E. Line
 _____ Ft. from W. Line

RECORD

Cased in _____ ft.
 Sand _____
 Gas _____
 Oil _____

Location _____
 Rig up _____
 Drilling and Remarks _____

- Misc. Small Maps _____
- Cards _____
- Tracing _____
- France Map _____
- Scarborough Map _____
- Moody Map _____
- Geological Dept. _____
- Moody Plat Book _____

Handwritten signatures and initials:
 [Large signature]
 [Initials]
 [Signature]

Date _____

Map No. 92 Sec. 35 Twp. 30 R. 15W

Well No. 1 Massey

Pryor & Lockhart et al. Company

COMPLETED

Contractor

C E L N E N W

SECTION PLAT

660 Ft. from N. Line

_____ Ft. from S. Line

330 Ft. from E. Line

_____ Ft. from W. Line

WILDCAT

Location _____

Rig up _____

Drilling and Remarks:

Liana 8907

7" @ 4448

3 5/8" to 4342-44

24 " 4342-44

Boiler & P.Y. 6112

May 3000

930 48

RECORD

Cased _____ in., _____ ft.

Sand _____

Gas _____

Oil _____

Total Depth 4719

PRODUCTION

1st 24 hrs. Nat. _____

1st 24 hrs. after shot _____

Gas _____ Cu. Ft.

Dry Hole _____

Abandoned _____

Date

DEC 23 1941

19

S. J. LEWIS

Scout

Wm. I. Massey

Pryor & Lockhart et al., Company

Contractor

SECTION PLAT

C. E. I. N. E. W.

660 ft. from N. Line

ft. from S. Line

330 ft. from E. Line

ft. from W. Line

WILDCAT

RECORD

Location _____
 Foot up _____
 Drilling and Reservoir _____

- Misc. Small Maps *Paul*
- Cards *Paul*
- Tracing *W.K.*
- France Map *Ray*
- Scarborough Map *Ray*
- Meedy Map *Ray*
- Geological Dept. _____
- Meedy 1st Book _____

Date

1892