


Section 35 Township 30 Range 15-W

Well No. #2 Massey

Company Great Lakes Carbon et al

NORTH Sun City Pool

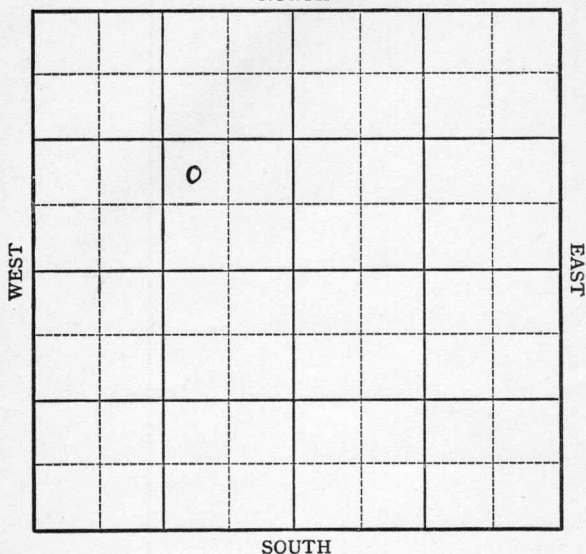

KANSAS

Barber

Sec. 35 Twp. 30 R. 15-W

Well No. #2 Massey Farm

Great Lakes Carbon et al Company
(Sun City Pool)


 Ft. from N. Line

990 Ft. from S. Line

990 Ft. from E. Line

 Ft. from W. Line

Elev. 1741

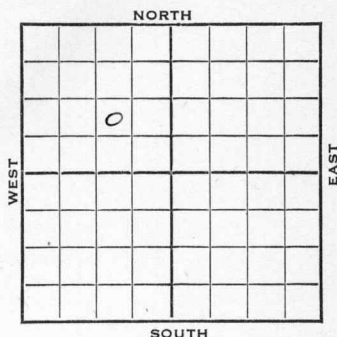

1942

REPORT

7/22

Location

7/29

Rotary

8/5

10" - 168

Drlg. 1965'

8/12

Topeka 3025

Drlg. 3207

8/19

No report.

8/27

Lans 3870

TD 4346

No shows SD

9/2

"

"

"

9/9

Lans. 3870

No shows

TD 4346

ABANDONED

Barber

KANSAS

Map No. 92 Sec. 35 Twp. 30 R. 15WWell No. 2 MasseyGreat Lakes Carbon et al companyFIRST REPORT

Contractor

NW SE NW

_____ Ft. from N. Line

990 Ft. from S. Line990 Ft. from E. Line

_____ Ft. from W. Line

SUN CITY POOL

SECTION PLAT

	0		

Location XXX

Rig up _____

Drilling and Remarks:

RECORD

Cased _____ in., _____ ft.

Sand _____

Gas _____

Oil _____

Total Depth _____

PRODUCTION

1st 24 hrs. Nat. _____

1st 24 hrs. after shot _____

Gas _____ Cu. Ft.

Dry Hole _____

Abandoned _____

Date

JUL 22 1942

19


S. J. LEWIS Scout

Map No. 92 Sec. 35 Twp. 30 ~~20~~ R. 15WWell No. 2 MasseyGreat Lakes Carbon et al. Company**ABANDONED**

Contractor

NW SE NW

SECTION PLAT

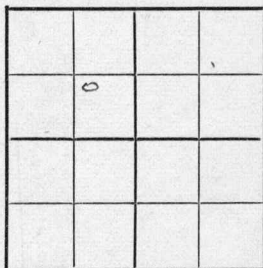 Ft. from N. Line990 Ft. from S. Line990 Ft. from E. Line Ft. from W. Line

SUN CITY POOL

Location Rig up

Drilling and Remarks:

Leans 3870No shovels

RECORD

Cased in., ft.Sand Gas Oil Total Depth 4346

PRODUCTION

1st 24 hrs. Nat. 1st 24 hrs. after shot Gas Cu. Ft.Dry Hole Abandoned

Date

SEP 9 1942 19S. J. LEWIS Scout