


Section 35 Township 30 Range 13W

Well No. #1 Hartley

Company Musgrove

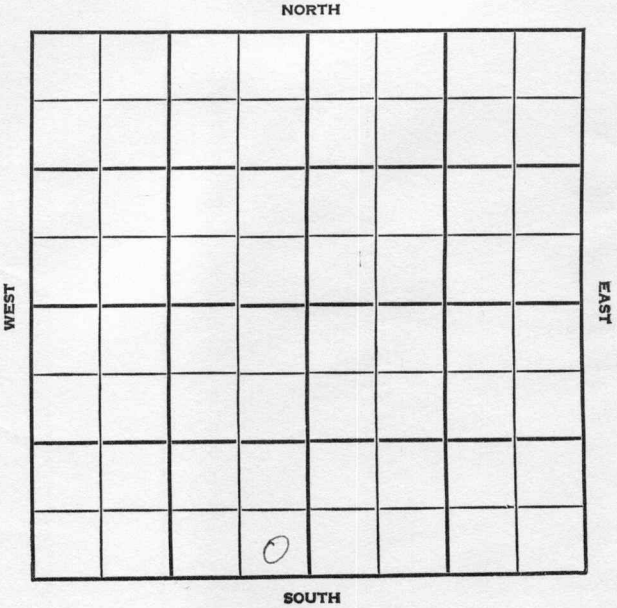

Barber

KANSAS

SEC.

35

TWP.

30

R.

13W

WELL NO.

#1 Hartley

FARM

COMPANY

Musgrove

CONTRACTOR

Sierra

WILDCAT


____ FT. FROM N. LINE

____ FT. FROM S. LINE

____ FT. FROM E. LINE

____ FT. FROM W. LINE

SE SE SW

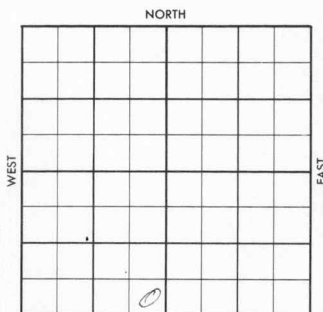SDX - $\frac{1}{2}$ mileGulf, Magnolia, Sohio -
& Texas - Support.

1956

ELEVATION

1778'

REPORT

6-27 MIR

7-12 Heeb. 3689'; Doug.sh. 3723';
Doug. sd. 3827'; Lans. 3855';
DST 3823-39, op 1 hr, 1270' GIP, rec.
150' hg & socmsw, 300' gassy sw, 1300#.
Drlg. 4233'

7-19 Miss. 4325', Kh. 4432', Viola 4516';
Simp. 4630'; Arb. 4719';
DST 4295-4317', op 1 hr, rec. 480' GIP
32' so&gcm, 115/20".
DST 4323-43', op 1 hr, rec. 32' vs gcm,
260/20".
DST 4506-36', op $\frac{1}{2}$ hr, rec. 15' mud,
0/20". #
Drlg. 4744'

7-25 Comm. 6-28-56
8 5/8" @ 384 w/250
D & A

Log tops: H. 3686'; Eg. sh. 3720';
Dg. sd. 3824'; L. 3853'; M. 4322';
K. 4430'; V. 4512'; S. 4628'; A. 4728';
TD 4761';

ABANDONED

726

County Barber Elev.

Sec. 35 Twp. 30 Rge. 13W

Company Musgrove

Farm Name Hartley No. 1

TOPS	DEPTH	LOG	DATUM	Loc. in Sec.
Anh.				SE SE SW
Tp.				
H.				
Tr.				
Dg.				
BL.				
L.				Geol.
K.C.				Contr.
B.K.C.				Sierra
Ce.				Pool
C.				Wildcat
M.				
M.				
K.				
Mz.				
Me.				
V.				
S.				
S.				
A.				
R.				
Pe.				
G.				
TD.				

Date Comm. Gulf, Magnolia, Sohio & Texas support

M I R

JUL 1 1958

68

1/2 mile
FIRST REPORT
JUN 27 '58

County Barber Elev. 1778 Co. 1
 Sec. 35 Twp. 30 Rge. 13W
 Company Musgrove
 Farm Name Hartley No. 1

	DEPTH	LOG	DATUM	Loc. in Sec.
				SE SE SW
	3689	3686		
Tr.				
Dg. <u>Sh</u>	3723	3720		
Bt. <u>D95d</u>	3827	3824		
L.	3855	3853		
K.C.				Geol.
B.K.C.				Contr.
Ce.				Sierra
C.				
M.	4325	4322		
M.				Pool
K.	4432	4430		Wildcat
Mz.				ABANDONED
Me.				
V.	4516	4512		
S.	4630	4628		
S.				
A.	4719	4728		<u>1/2 mile</u>
R.				JUL 25 1956
Pe.				
G.				
T.D.	4761	4759	4761	0

Date Comm. Gulf, Magnolia, Sohio & Texas support

MIR JUL 3 '56 6-28-56 85/8 384
 1250 ϕ 2305 JUL 11 '56
 DST 3823-39 1hr 1270' GIP
 rec 150' HG & SOC MSW + 300'
 9554 SW 50-220 BHP 1300
 ϕ 4233 JUL 18 '56 DST 4295-4317
 1hr 480' GIP rec 32' 50' 6CM
 BHP 115/20" DST 4323-43 1hr
 rec 32' VSGCM BHP 260/20"

DST 4506-36 30" rec 15' Md
Hil press 0/20" ID 4744 JUL 25 '56

DEA