

KANSAS


FORM 51 5M 1-42 PETROL

Barber

Section 35 Township 30 Range 14W

Well No. #1 Frank Buck

Company Huber Oil

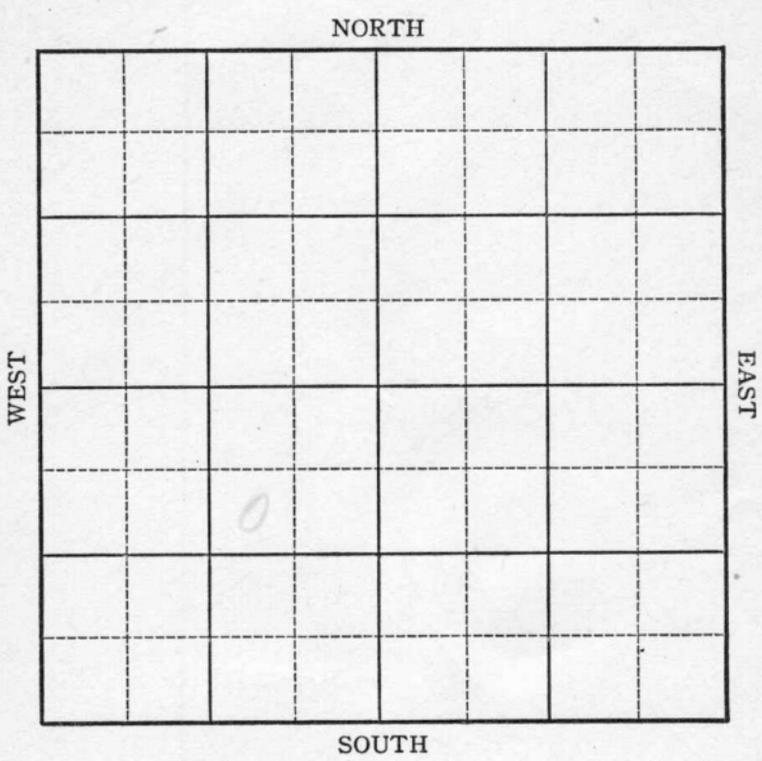

KANSAS

Sec. 35 Twp. 30 R. 14W

Well No. #1 Frank Buck Farm

Huber Oil Company


Skinner

990 Ft. from N. Line

 Ft. from S. Line

990 Ft. from E. Line

 Ft. from W. Line

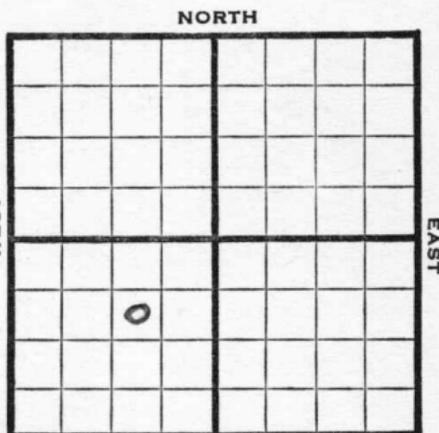

SW NE SW Elev. 1743

1944

REPORT

8/16	Drk.
8/23	Surface hole
8/30	8" @ 794 DRILg. 1900
9/8	Drlg. 3285'
9/13	Drlg. 4176
9/21	Douglas 3732 Lans 3875 Viola 4496 Drlg. 4560
9/28	S imp 4596 3d 4611 Arb 4684 TD 4696 PB
10/4	5 1/2" @ 4455 RUST
10/11	" " " "
10/18	50 qts 4330-60 1400 acid PB 4324 39 shots 4309-21 2000aci PB 4298-14 shots 3844-49 200' W Squeeze
10/25	" " " " " " " " " "
11/8	Arb 4684 5 1/2" @ 4455 TD 4696 Lost Hole

ABANDONED

KANSAS

Pool Name Skinner

Map No. 92 Sec. 35 Twp. 30 R. 14W

Well No. 1 Frank Buck

Huber Oil

Company

FIRST REPORT

Contractor

SW NE SW


SECTION PLAT

990 Ft. from N. Line

_____ Ft. from S. Line

990 Ft. from E. Line

_____ Ft. from W. Line

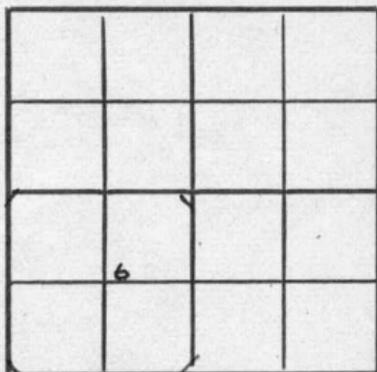

Barber County

Location _____

RECORD

Cased _____ in., _____ ft.

Rig up _____

Sand _____

Drilling and Remarks:

Gas _____

Derrick

Oil _____

Total Depth _____

PRODUCTION

1st 24 hrs. Nat. _____

1st 24 hrs. after shot _____

Gas _____ Cu. Ft.

Dry Hole _____

Abandoned _____

Date

AUG 16 1944 19

S. J. LEWIS Scout

