

KANSAS


Barber

Form 51-5M-7-39-Palace

Section 35 Township 30 Range 14W

Well No. #1 Buck

Company Transwestern

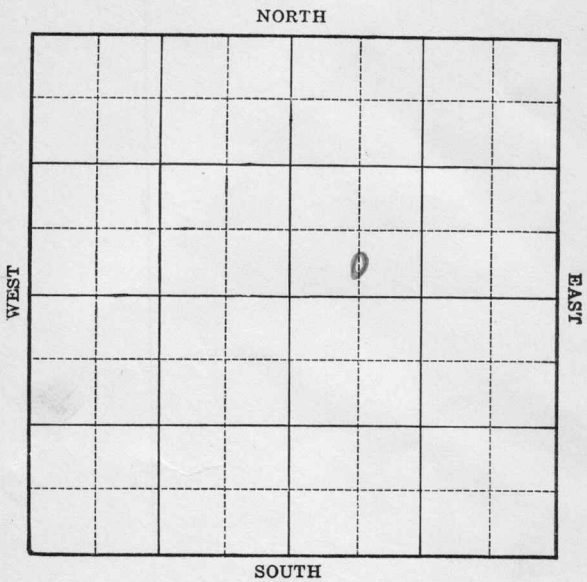

KANSAS

Barber

Sec. 35 Twp. 30 R. 14-WWell No. #1 Buck FarmTranswestern Company

(Wildcat)


_____ Ft. from N. Line

330 Ft. from S. Line

_____ Ft. from E. Line

660 Ft. from W. Line

Elev. 1705

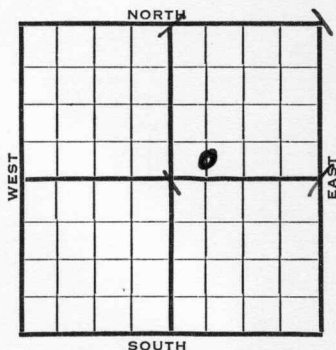

1940	REPORT
7/10	Derrick.
7/18	13" - 246' WOC.
7/25	698' run 10".
8/2	10" - 724' Drlg. 2634'
8/8	Drlg. 3650'
8/14	Lansing 3821'
	Drlg. 4314'
8/22	Miss. 4320' Misener 4382'
	Viola 4389' Simp. 4536'
	Core 4550-52' no shows.
	Drlg. 4593'
8/28	Viola 4389
	Arb. 4621
	TD 4653
	No shows
	ABANDONED

Map No. 92 Sec. 35 Twp. 30 R. 14WWell No. 1 BuckTranswestern Company

Contractor


FIRST REPORT

C S L SW NE

 Ft. from N. Line330 Ft. from S. Line Ft. from E. Line660 Ft. from W. Line

WILDCA T

SECTION PLAT

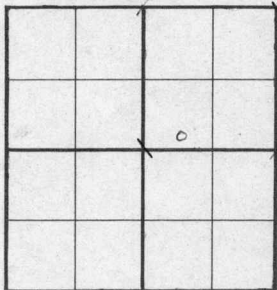Location Rig up

Drilling and Remarks:

Derrick

RECORD

Cased in., ft.Sand Gas Oil Total Depth

PRODUCTION

1st 24 hrs. Nat. 1st 24 hrs. after shot Gas Cu. Ft.Dry Hole Abandoned

Date

JUL 10 1940 19

S. J. LEWIS Scout

KANSAS

Map No. 92 Sec. 35 Twp. 30 R. 14WWell No. 1 Buck

Transwestern

Company

Contractor

ABANDONED

SECTION PLAT

C S L SW NE

Ft. from N. Line

330 Ft. from S. Line

Ft. from E. Line

660 Ft. from W. Line

WILDCAT

Location _____

Rig up _____

Drilling and Remarks:

*Vidla 4389**Ar 4621**No shows.*

RECORD

Cased _____ in., _____ ft.

Sand _____

Gas _____

Oil _____

Total Depth 4653

PRODUCTION

1st 24 hrs. Nat. _____

1st 24 hrs. after shot _____

Gas _____ Cu. Ft.

Dry Hole _____

Abandoned _____

Date

AUG 28 1940

19

S. J. LEWIS Scout