FORM 51 10M 2-49 PETROL


KANSAS

Grant

Section 35 Township 30S Range 35W

Well No. #1 Kuhn "C"

Company Magnolia Pet, Co.

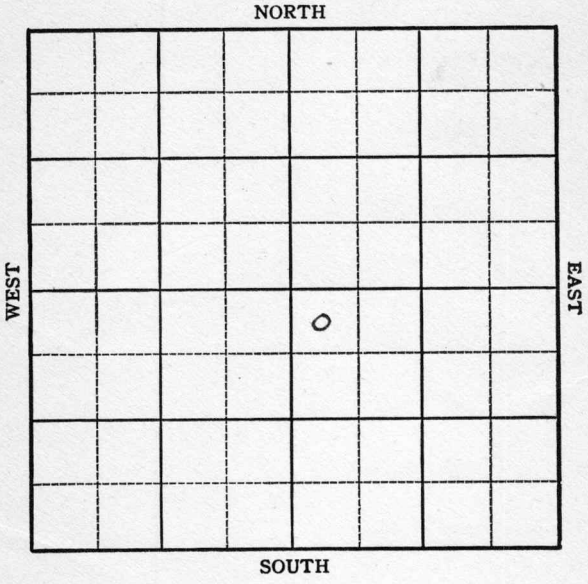

FORM 252-A
5M 10-48 PETROL

Grant KANSAS

Sec. 35 Twp. 30 R. 35W

Well No. #1 Kuhn "C" Farm

Magnolia Company

Hugoton Pool (Barnett Drlg., Comp.)


330' Ft. from N. Line

Ft. from S. Line

Ft. from E. Line

330' Ft. from W. Line

NW SE

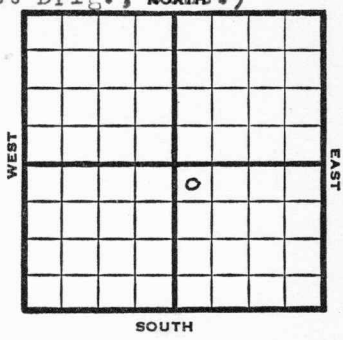

1949	Elv 2911' REPORT
9/7	Location
9/14	10"@ 647' Drlg 1500'
9/21	7" @ 2689' TD 2690'
9/28	28$ shots 2562-2643' 14000 acid
10/5	26$ shots 2462-2540 21000 acid
10/12	"
10/19	TD 2690' 7"@ 2689' Perf 35000 acid 29,260,000 Gas 405# R Pr. Comp

COMPLETED

...s. 6-49 Petrol

Kansas

Hugoton Pool

Sec. 35 Twp. 30 R. 35W

1 Kuhn "C"


Magnolia Company

Barnett Drlg. Contractor

W SE

FIRST REPORT

SECTION PLAT

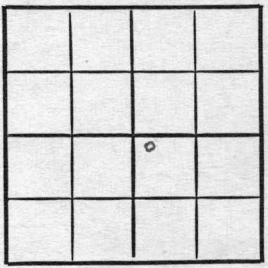

330 Ft. from N. Line

Ft. from S. Line

Ft. from E. Line

330 Ft. from W. Line

Grant County

Location x

Rig up

Drilling and Remarks:

RECORD

Cased in., ft.

Sand

Gas

Oil

Total Depth

PRODUCTION

1st 24 hrs. Nat.

1st 24 hrs. after shot

Gas Cu. Ft.

Dry Hole

Abandoned

Date

SEP 7 1949 19 S. J. LEWIS Scout

Form 26-200-Bks. 6-49 Petrol

Kansas

Hugoton Pool

Map No. _____ Sec. 35 Twp. 30 R. 35W


Well No. 1 Kuhn "C"

Magnolia Company

Barnett Drlg. Contractor

NW SE CORRECTION

SECTION PLAT

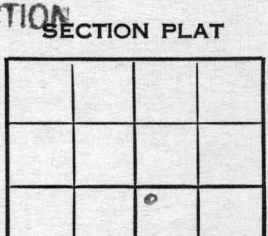

330 Ft. from N. Line

_____ Ft. from S. Line

_____ Ft. from E. Line

330 Ft. from W. Line

FIRST REPORT

Grant County

Location x

Rig up _____

Drilling and Remarks:

Reported in
Finney County

RECORD

Cased _____ in., _____ ft.

Sand _____

Gas _____

Oil _____

Total Depth _____

PRODUCTION

1st 24 hrs. Nat. _____

1st 24 hrs. after shot _____

Gas _____ Cu. Ft.

Dry Hole _____

Abandoned _____

Date

_____ 19 _____

S. J. LEWIS Scout

Form 26 200 Bks. 6-49 Petrol

Kansas

Hugoton Pool

Map No. _____ Sec. 35 Twp. 30 R. 35W

Well No. 1 Kuhn "C"


Magnolia Company

COMPLETE Contractor

NW SE

£1,281

SECTION PLAT

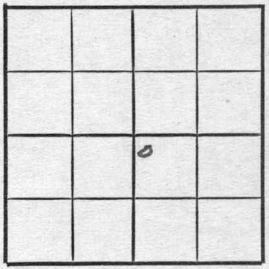

330 Ft. from N. Line

_____ Ft. from S. Line

_____ Ft. from E. Line

330 Ft. from W. Line

Grant County

Location _____

Rig up _____

Drilling and Remarks:

7" @ 2659

Ref.

25000 acid

29,260,000 flow

405# RP

RECORD

Cased _____ in., _____ ft.

Sand _____

Gas _____

Oil _____

Total Depth 2680

PRODUCTION

1st 24 hrs. Nat. _____

1st 24 hrs. after shot _____

Gas _____ Cu. Ft.

Dry Hole _____

Abandoned _____

Date

OCT 19 1949 19

S. J. LEWIS Scout