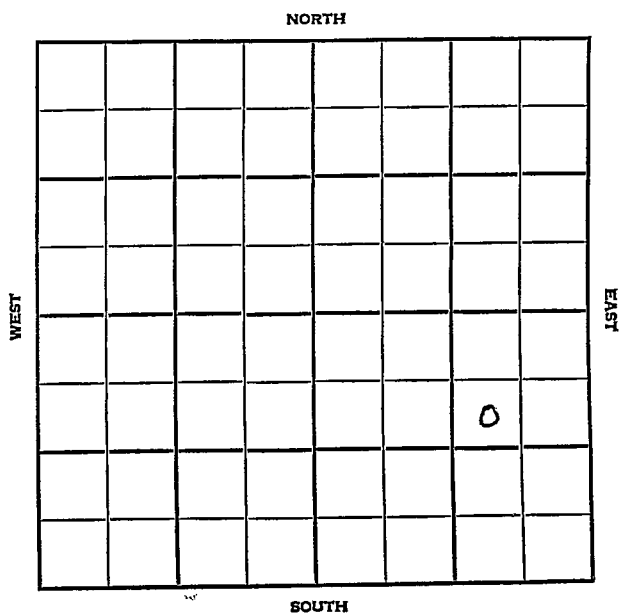


Section 35 Township 30 Range 9 WWell No. #1/Morris & Wolf "B"Company Magnolia Pet.

Kingman

KANSAS

SEC.	TWP.	R.
35	30	9W

WELL NO.

#1 Morris & Wolf "B"

FARM

COMPANY

Magnolia Pet.

CONTRACTOR

Bass

Sunnyview


_____ Ft. from N. Line

_____ Ft. from S. Line

_____ Ft. from E. Line

_____ Ft. from W. Line

SW NE SE

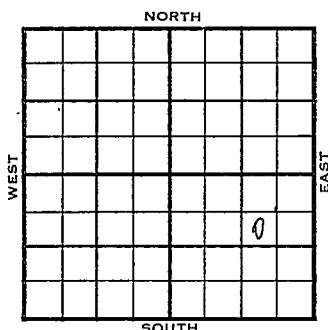

1956

ELEVATION

1690

REPORT

2-15

Comm. 2-13-56

9" @ 198/225

Dr1g. 1130

3/28

Comm 2-13-56

H 3460

L 3662

Chat 4401 4402

K 4586

Chatta sd 4648

V 4680 4683

S 4747 4750

A 4868 4867

TD 4910 4910

9" @ 198/225 DST 4404-21 open 1 hr

gas in 2½ min 900 mcfg rec 58' gcm

4410/20" DST 4421-41 open 1 hr

gas in 1 min 1790 mcfg rec 45' clean

oil 105' ho & gcm 1089/20"

DST 4441-65 open 1 hr rec 150' o &

gcm 3184/20" DST 4685-4703 open 1 hr

OVER

1956

3/28

rec 1680' gassy sw 1700/20"
5 1/2" @ 4909 CO 100/4420-40 F/gas
184 mcfg 500 A frac F/78 bo 12% wtr
20 hr 877 MCFG F.83 BO 11 BW 24 hr
1,200 MCFG 70/4406-20 F/10 bo 6 bw
3 hr 1000 A F/735 mcfg
F/62 BO 8 bw 24 hr F/165 bo 14 bw 15 h
F 78 bopd
Comp open flow 5,350 mcfgpd

COMPLETED

County Kingman Elev. 9W
 Sec. 35 Twp. 30 Rge. 9W
 Company Magnolia Pet.
 Farm Name Norris & Wolf "B" No. 1

TOPS	DEPTH	LOG	DATUM	Loc. in Sec.
Anh.				SW NE SE
Tr.				
H.				
Tr.				
Dg.				
Bl.				
L.				Geol.
K.C.				Contr.
B.K.C.				Bass
Ce.				Pool
C.				Sunnyview
M.				
M.				
K.				
Mz.				
Me.				
V.				
S.				
S.				
A.				
R.				
Pe.				
G.				
T.D.				

Date Comm. 2-13-56
9" @ 198/225 drlg. 1130

27

FEB 20 1956

R. G.

County Kinaman Elev. 1690
 Sec. 35 Twp. 30 Rge. 9W
 Company Magnolia Pet.
 Farm Name Morris & Wolf "B" No. 1

TOPS	DEPTH	LOG	DATUM
App.			
TP			
H.		<u>3460</u>	
Tr.			
Dg.			
BL.			
L.		<u>3662</u>	<u>1972</u>
K.C.			
B.K.C.			
Ce.			
C.			
M. <u>clat</u>	<u>4401</u>	<u>4402</u>	<u>2712</u>
M.			
K.		<u>4586</u>	<u>2896</u>
Mz. <u>Chatta al</u>		<u>4648</u>	<u>2958</u>
Me.			
V.	<u>4680</u>	<u>4683</u>	<u>2993</u>
S.	<u>4747</u>	<u>4750</u>	<u>3060</u>
S.			
A.	<u>4868</u>	<u>4867</u>	<u>3177</u>
R.			
Pe.			
G.			
TD.	<u>4910</u>	<u>4910</u>	

Loc. in Sec. _____


SW NE SE

Geol. _____

Contr. _____

Pool _____

Sunnyview

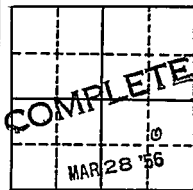Date Comm. 2-13-56

9" @ 198/225 DST 4404-21 open 1 hr.

gas in 2½ min. 900 mcfg rec. 58' gcm

1410/20" DST 4421-41 open 1 hr.

gas in 1 min. 1790 mcfg rec. 45' clean

oil 105' ho & gcm 1089/20"

DST 4441-65 open 1 hr. rec. 150' o &

gcm 3184/20" DST 4685-4703 open 1 hr.

OVER

rec. 1680' gassy sw 1700/20" 5 $\frac{3}{4}$ " @ 4909

CO 100/4120-10 F/gas 184 mcfg

500 A frac F/78 bo 12% wtr.

20 hr. 877 mcfg F. 83 bo 11 bw 24 hr.

1,209 mcfg 70/4106-20 F/10 bo

6 bw 3 hr. 1000 W F/735 mcfg

F/62 bo 8 bw 24 hr. F/165 bo

14 bw 15 hr. F. 78 bopd

Comp. open flow 5,350 mcfgpd

M. MC.

APR 6 1956