DX 78-1


Kingman

KANSAS

Section 35 Township 30 Range 9W

Well No. #1 Lee

Company Pickrell Drlg.

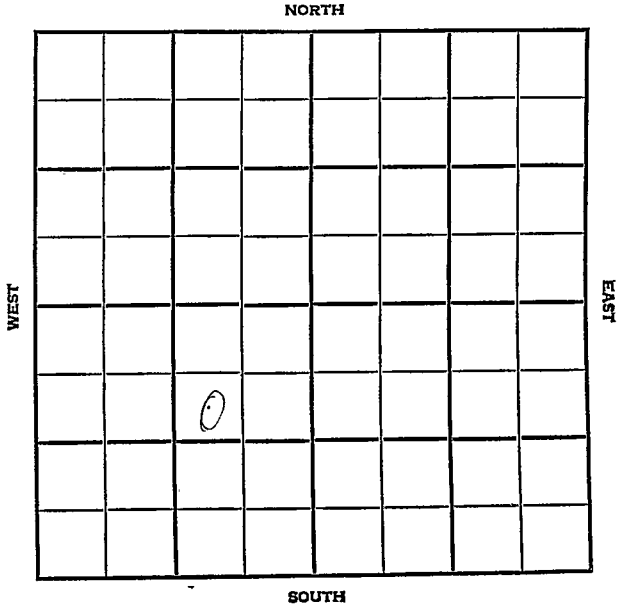

FORM 513 SUNRAY

County Kingman Elev.

Sec. 35 Twp. 30 Rge. 9W

Company Pickrell Drlg.

Farm Name Lee No. 1

TOPS	DEPTH	LOG	DATUM
Anh.			
T.P.			
H.			
Tr.			
Dg.			
Bl.			
L.			
K.C.			
B.K.C.			
Ce.			
C.			
M.			
M.			
K.			
Mz.			
Mq.			
V.			
S.			
S.			
A			
R.			
P€.			
G.			
T.D.			

Loc. in Sec. SW NE SW

Geol.

Contr. Co. Tools

Pool Spivey-Grabs

FIRST REPORT

OCT 24 1956

Date Comm. spd. 10-19-56

8" @ 200 w/225, lost circl @ 170, Drlg.

2200

Co. Lse. No. Sec. T. R.

FORM 513 SUNRAY

County Kingman Elev. 1695 Co.

Sec. 35 Twp. 30 Rge. OW

Company Pickrell Drlg.

Farm Name Lee No. 1

TOPS	DEPTH	LOG	DATUM
Anh.			
Tp.			
H.			
Tr.			
Dg.			
Bl.			
L.			
K.C.			
B.K.C.			
Ce.			
C.			
M.	4411		
M.			
K.			
Mz.			
Mg.			
V.			
S.			
S.			
A			
R.			
PE.			
G.			
TD	4570		

Loc. in Sec. SW NE SW

Geol.

Contr. Co. Tools Lse.

Pool Spivey-Grabs

COMPLETE

MAR 20 '57 No.

Date Comm. spd. 10-19-56 Sec.

8" @ 200 w/225, lost circl @ 170, Drlg.

2200 to 31 '56 TD 4260 NOV 7 '56 T.

DST 4424-50 1hr 6/2" ga

1,250 MCF ga 95' GCM BHP

1550/ 4½ 4503/100 WOCT

NOV 13 '56 NOV 21 '56 NOV 28 '56 DEC 5 CO R.

40/4440-50 40/4427-37 40/4414

-24 ga 80 MCF Frac 8 X 8

Flwd 7 BFPh (27#wt) ga 4,500 MCF

FORM 513-1 SUNRAY

FCP 900 # 3/4" ch S. I. DEC '2 '56

DEC 3 '56 JAN 2 '57

FEB 20 '57 FEB 21 '57 9a 4,435

MCFG + 4 1/2 Boph + Trwtr

MAR 13 '57

9a 4,435 MCFGpd + 4 1/2 Boph 3/4" ch.

comp. S.I. GAS well

35 - 30 - 9W SW NE SW