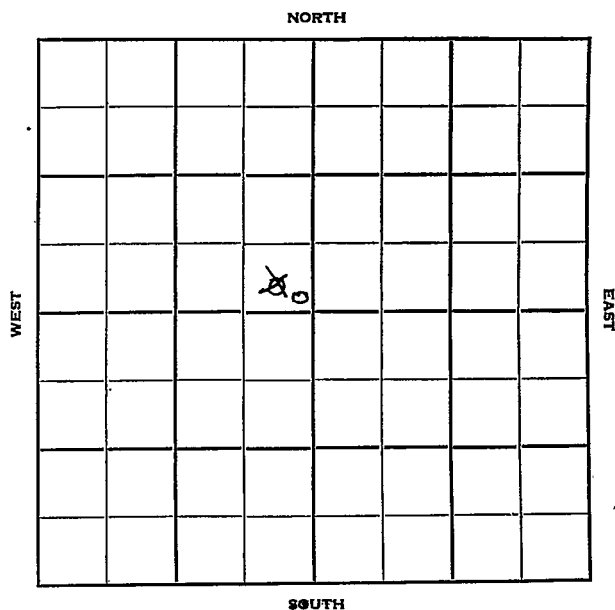


Section 35 Township 30 Range 32WWell No. 1 Meyers "A"Company Cities Service Oil

Haskell KANSAS

Sec. 35 Twp. 30 R. 32W ✓

Well No. #1 Meyers "A" Farm

Cities Service Oil Company

Contractor


Ft. from N. Line

100' Ft. from S. Line

100' Ft. from E. Line

Ft. from W. Line

SE SE NW

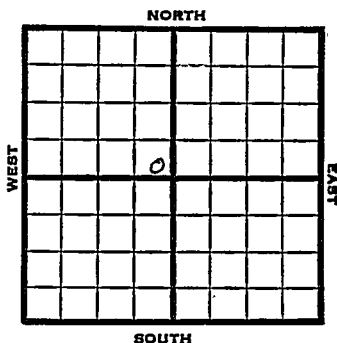

1951 Elv. 2847' REPORT

7/18 Location

9/19 Spud 7-18-51
Gas Well TD 2720
8" @ 576
5" @ 2719
TD 2720
Her. 2576 Kri 2602
Win. 2672
80/2672-88 150/2628-58 70/2602-16
25,000 A Comp. 18,300,000 gas
416#

COMPLETED

County Haskell State Kansas

Sec. 35 (Blk. Twp.) 30 (Sur. Rge.) 32W Map No.

Operator **Cities Service Oil**

Well No. 1 Farm Nevers "A"

Elev.	Location	SE SE NW

0

FIRST REPORT

100 Ft. From S Line NW

100 Ft. From E Line Quarter

1st. Report JUL 18 1951

Completion

Remarks


Spudding Date

Drbg. Data

Location

J. E. TYRA

County Haskell State Kansas
 Sec. 35 (Blk. 30) (Sur. 3 2W) (Twp. 30) Map No. 3 2W
 Operator Cities Service
 Well No. 1 Farm Meyers "A"
 Elev. 2847 Location SE SE NW

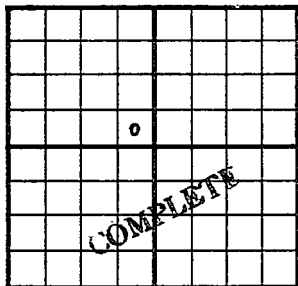

100 Ft. From S Line NW
 100 Ft. From E Line Quarter

Ist. Report

Completion SEP 19 1951

Remarks

Spudding Date 7-18-51

Drlg. Data Gas well TD 2720

8" @ 576 5" @ 2719 TD 2720

Her. 2576 Kri. 2602 Win. 2672

80/ 2672-88 150/ 2628-58 70/ 2602-16

25000 A Comp. 18,300,000 gas 416#

J. E. TYRA