


Map No. **KANSAS** Sec. **35** Twp. **30** R. **24**
 Well No. **1-~~2200~~ Grant** Farm
DeForest Drilling Company

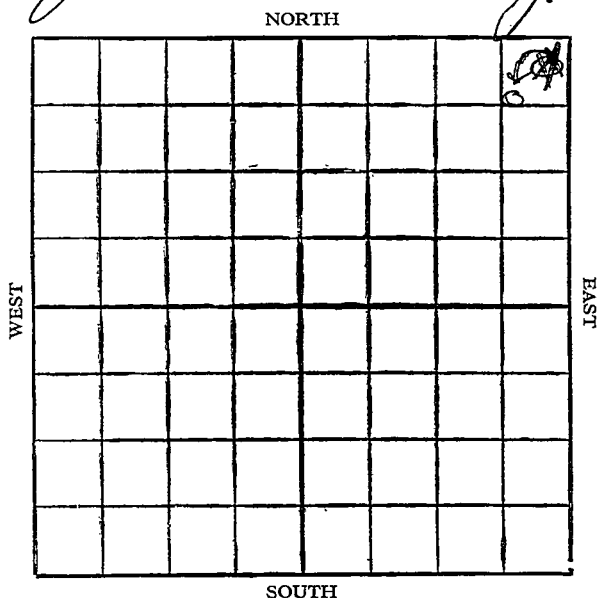

Location

Drilling Remarks

Rig Up

Drilling Remarks

RECORD

Cased in. ft.

Sand

Gas

Oil

Total Depth

PRODUCTION

1st 24 hrs. Nat.

1st 24 hrs. after shot

Gas cu. ft.

Dry Hole

Abandoned

Map No. KANSAS Sec. 35 Twp. 30 R. 2WWell No. 1 MoserDeForest & Drilling CompanyJ Contractor

SECTION PLAT

100 Ft. from N. Line

_____ Ft. from S. Line

100 Ft. from E. Line

_____ Ft. from W. Line

			0

FIRST REPORTS

Location _____

Rig up _____

Drilling and Remarks:

RECORD

Cased _____ in., _____ ft.

Sand _____

Gas _____

Oil _____

Total Depth _____

PRODUCTION

1st 24 hrs. Nat. _____

1st 24 hrs. after shot _____

Gas _____ Cu. Ft.

Dry Hole _____

Abandoned _____

Date

MAY 3 1 1928

S. J. LEWIS

Scout

Map No. KANSAS Sec. 25 Twp. 30 R. 2 W

Well No. 1 Frantz

DeForest & Hing Company

Contractor

SECTION PLAT

650 Ft. from N. Line

_____ Ft. from S. Line

600 Ft. from E. Line

_____ Ft. from W. Line

			0

Correction

Location _____

Rig up _____

Drilling and Remarks:

Reported this
as Mosley farm.
and 100 yds from N.
line and 100 yds from
E. line

RECORD

Cased _____ in., _____ ft.

Sand _____

Gas _____

Oil _____

Total Depth _____

PRODUCTION

1st 24 hrs. Nat. _____

1st 24 hrs. after shot _____

Gas _____ Cu. Ft.

Dry Hole _____

Abandoned _____

Date _____

S. J. LEWIS

JUN 13 1928

Scout

MAP No. _____ SEC. 35 TWP. 30S R. 7WWELL No. 1 MoorReformed Only. COMPANY _____chunks out
our walling CONTRACTOR _____

SECTION PLAT

			o

_____ FT. FROM N. LINE

_____ FT. FROM S. LINE

_____ FT. FROM E. LINE

_____ FT. FROM W. LINE

LOCATION _____

RIG UP _____

DRILLING AND REMARKS:

1919-28
3M - good

RECORD

CASED _____ IN _____ FT.

SAND _____

GAS _____

OIL _____

TOTAL DEPTH 1928

PRODUCTION

1ST 24 HRS. NAT. _____

1ST 24 HRS. AFTER SHOT _____

GAS 3M CU. FT.

DRY HOLE _____

ABANDONED _____

DATE

7/20 1928 _____ SCOUT

Superior
 Map No. *MISSAS* Sec. *35* Twp. *30* R. *2W*

Well No. *1 Frantz**Texpress Drilling* Company*J* Contractor

SECTION PLAT

650 Ft. from N. Line

----- Ft. from S. Line

600 Ft. from E. Line

----- Ft. from W. Line

			<i>0</i>

COMPLETED

Location -----

Rig up -----

Drilling and Remarks:

*Sand 1919 &**1926 3 M. Gas**TII 1928 shale***RECORD**

Cased ----- in., ----- ft.

Sand -----

Gas -----

Oil -----

Total Depth -----

PRODUCTION

1st 24 hrs. Nat. -----

1st 24 hrs. after shot -----

Gas ----- Cu. Ft.

Dry Hole -----

Abandoned -----

Date

JUL 25 1928

S. J. LEWIS

192

Scout