

Section 35 Township 30 Range 2W

Well No. 1 Frantz

Company Consolidated Gas & Anderson Prichard

NORTH

							0

WEST

EAST

SOUTH

KANSAS

Summer

Sec. 35 Twp. 30 R. 2-W

Well No. #1 Frantz Farm

Consolidated Gas & Anderson-Prichard Company

Wildcat


330' Ft. from N. Line

_____ Ft. from S. Line

330' Ft. from E. Line

_____ Ft. from W. Line

NE/C

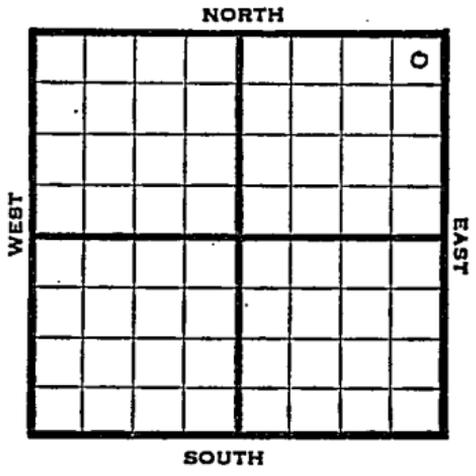

1947	Elev. 1332'	REPORT
12/10	Location	
12/17	"	
12/30	RUR	
1948		
1/7	10" @ 440' Drlg. 665'	
1/14	Drlg 2960'	
1/21	Mississippi 3736' KC 3083' Drlg. 3775'	
1/26	7" @ 3742' TD 3779'	
2/4	"	
2/17	1000 Acid 2M Gas 50 bbls. fluid a day 20% W	
2/18	"	
2/25	"	
3/3	Miss. 3736' 7" @ 3742' Acid 4000 Flow 38 oil / 15% W Pot. Gr. 47° Total Depth 3779'	
	COMPLETED	

Map No. _____ Sec. 35 Twp. 30 R. 2W

Well No. 1 Frantz

Consolidated Gas & Anderson-Pricha.
Company

FIRST REPORT

Contractor

NE/C

SECTION PLAT

330 Ft. from N. Line

_____ Ft. from S. Line

330 Ft. from E. Line

_____ Ft. from W. Line

			0

Sumner County

Location X

Rig up _____

Drilling and Remarks:

RECORD

Cased _____ in., _____ ft.

Sand _____

Gas _____

Oil _____

Total Depth _____

PRODUCTION

1st 24 hrs. Nat. _____

1st 24 hrs. after shot _____

Gas _____ Cu. Ft.

Dry Hole _____

Abandoned _____

Date

DEC 10 1947

19

S. J. LEWIS

Scout

Map No. 38 Sec. 35 Twp. 30 R. 2W

Well No. 1 Frantz

Consolidated Gas & Anderson Prichard
Company

COMPLETE

Contractor

NE/C

E1,132
SECTION PLAT

330 Ft. from N. Line

_____ Ft. from S. Line

330 Ft. from E. Line

_____ Ft. from W. Line

			0

Summer County

Location _____

Rig up _____

Drilling and Remarks:

Miss 8736
2" C 3742
4000 rods
Flow & Soil + 15%
W/B & Y
47 2/2

RECORD

Cased _____ in., _____ ft.

Sand _____

Gas _____

Oil _____

Total Depth 2877

PRODUCTION

1st 24 hrs. Nat. _____

1st 24 hrs. after shot _____

Gas _____ Cu. Ft.

Dry Hole _____

Abandoned _____

Date

MAR 3 1948 19

S. J. LEWIS Scout