
DX 78-1 Summer

KANSAS

Section 35 Township 30 Range 2W

Well No. #4 Franz (Frantz)

Company Anderson-Prichard

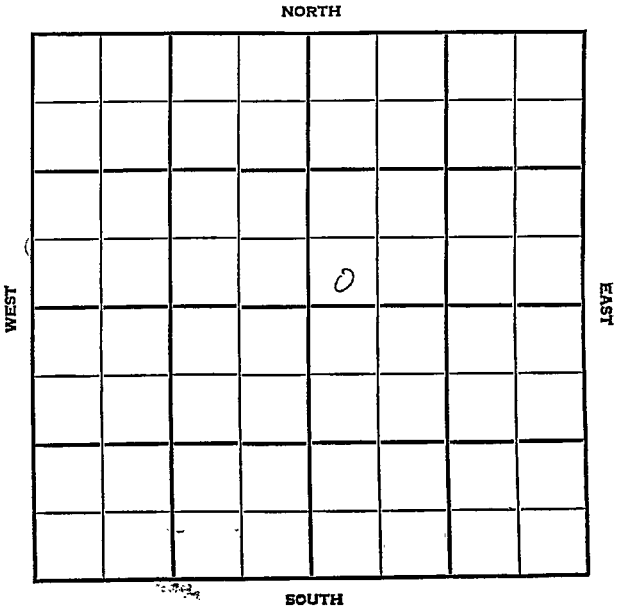

Sumner KANSAS

SEC.	TWP.	R.
35	30	2W

WELL NO.

#4 Franz FARM

COMPANY

Anderson-Prichard

CONTRACTOR

Peel

Anson


_____ FT. FROM N. LINE

_____ FT. FROM S. LINE

_____ FT. FROM E. LINE

_____ FT. FROM W. LINE

SW SW NE

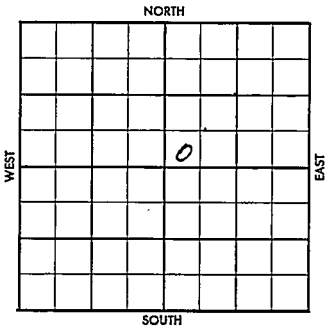

ELEVATION	REPORT
1956	
8-1	Location

FORM 504-5 SUNRAY

FORM 513 SUNRAY

County Sumner Elev.

Sec. 35 Twp. 30 Rge. 2W

Company Anderson-Prichard

Farm Name Franz No. 4

TOPS	DEPTH	LOG	DATUM
Anh.			
Tp.			
H.			
Tr.			
Dg.			
Bl.			
L.			
K.C.			
B.K.C.			
Ce.			
C.			
M.			
M.			
K.			
Mz.			
Mo.			
V.			
S.			
S.			
A			
R.			
P€.			
G.			
T.D.			

Loc. in Sec. SW SW NE

Geol.

Contr. Peel

Pool Anson

FIRST REPORT

Date Comm. AUG 1 1956

Location

Co. Lse. No. Sec. T. R.

FORM 513 SUNRAY



Company Anderson-Prichard

FarmName Franz No. 4

TOPS	DEPTH	LOG	DATUM
Anh.			
Tp.			
H.			
Tr.			
Dg.			
Bi.			
L.	3091	3090	
K.C.			
B.K.C.			
Ce.			
C.			
M.	3754	3755	
M.			
K.			
Mz.			
Mo.			
V.			
S.			
S.			
A			
R.			
Pe.			
G.			
T.D.	3840		

Loc. in Sec. SW SW NE

Geol.

Contr. Re 1

Pool Anson

COMPLETE

0

SEP 19 '56

Date Comm.

Location AUG 8 '56 AUG 15 '56 M I R

AUG 22 '56 8-13-56 8 3/8 443 1/150

@ 3230 AUG 29 '56 DST 3221-30

1hr 0/35" rec 60' HO&GCM

+180' HMCO +120' Free Oil

+180' SW BHP 1095/20"

DST 3760-85 1hr 0/179" rec

30' HGCM +180' HO&GCM +60'

HMCO BHP 1250/20" 5½ @ 3836

FORM 513-1 SUNRAY

co 3802 40/3775-85 Nz.
$ 71 BO + 55 BW 12 hrs
SEP 12 '56 P. 118 BO + 23 BW
24 hrs. SEP 13 '56 P. 100 BO + 23
BW 24 hrs.